

MISSISSIPPI DEPARTMENT OF NATURAL RESOURCES

Bureau of Land and Water Resources

P.O. Box 10631

Jackson, Mississippi 39209

WATER WELL DRILLERS LOG

COUNTY WELL LOCATED LINCOLN	
WELL NUMBER R 2045	CODED
DATE WELL COMPLETED 11-12-90	

PERMIT NUMBER
NAME OF DRILLING FIRM Easley Water Well
Shaven MS 39601

NAME & MAILING ADDRESS OF LANDOWNER Freddie R. Miller			
LINCOLN			
WELL LOCATION: SEC	TOWNSHIP	RANGE	
33	5	N 9 E S W	
DISTANCE	DIRECTION	NEAREST TOWN	
5 Miles	South of	Ruth	
OTHER LANDMARK			
WELL PURPOSE: Home, Irrigation, Municipal, Industrial, Fish Pond, etc. Home			

PUMP DATA		
PUMP TYPE (Circle One): <u>Submersible</u> Turbine, Jet, Flowing Well, Other (Describe) 1/2 HP		
POWER TYPE (Circle One): Electric, Tractor, Diesel, Gasoline, Butane, Other (Describe)		
Pump Capacity (GPM) 10	No. of Stages 9	Setting Depth FT.
PUMP TEST		
Well yielded _____ GPM with a drawdown of _____ ft. after _____ hours of pumping		

WELL DATA		
Well Depth 110'	Casing Diameter (In.) 4"	Casing Length (Ft.) 90'
Type of Casing PVC	Hole Depth 110'	Depth to Static Water Level
TYPE OF COMPLETION: (Circle One or More): Gravel Packed, Underreamed, Telescoped, <u>Natural Development</u> , Open Hole, Other (Describe)		
Top of Lap Pipe or Reduction in Casing		
FEET IF TELESCOPED OR MORE THAN ONE SCREEN: USE BACK PAGE		

LOG DATA	
TYPE OF LOG RUN (Circle One): Electric, Gamma Ray, Density, Sonic, Neutron, Other (Describe) <u>No Log Run.</u>	
Name of Organization Running Log	

SCREEN DATA		
Diameter - Inches 4"	Length - Feet 20'	Slot Size - Inches 0/0
Screen Type PVC	Depth to Bottom - Feet	


GEOLOGIC DATA (Office Use Only)			
Surface Elev.	Geologic Unit	Unit Thickness	Depth to Top
Subs. SWL	Date	Analysis	Aquifer Test
Driller's Remarks RECEIVED			
JUN 7 1991			

DESCRIPTION OF FORMATIONS ENCOUNTERED	FROM	TO	FORMATIONS (Continued)	
			FROM	TO
gray sand	0ft	20ft	Dept. of Environmental Quality	Quality
fine rocks	20ft	110ft	Bureau of Land & Water Resources	Resources

IF MORE SPACE IS NEEDED, USE BACK

If well telescopes please
sketch and show depths.

GROUND LEVEL

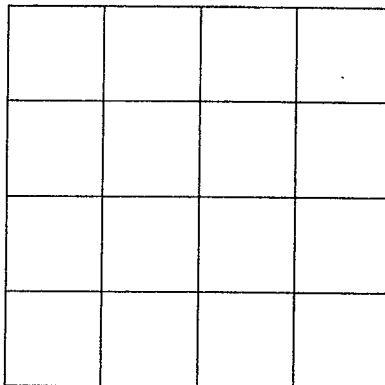

SECTION _____

Please indicate well location X.

ADDITIONAL INFORMATION

If more than one screen,
show location of each on sketch.