

Office of Land and Water Resources

WATER WELL DRILLERS LOG

COUNTY WELL LOCATED <i>Lincoln</i>		MISSISSIPPI
WELL NUMBER <i>R 2049</i>	CODS	
		PERMIT NUMBER
		NAME OF DRILLING FIRM <i>Green water well & Supply</i>
DATE WELL COMPLETED <i>9-19-94</i>		

NAME & MAILING ADDRESS OF LANDOWNER
R. C. Greer

3184 Daughdrill Trail S.E.

Bogue Chitto MS 39629

WELL LOCATION: SEC TOWNSHIP RANGE

4 S 9 W

DISTANCE DIRECTION NEAREST TOWN

10 Miles SE of Brookhaven

OTHER LANDMARK

WELL PURPOSE: Home, Irrigation, Municipal, Industrial, Fish Pond, etc.

Chicken Houses

PUMP DATA		
PUMP TYPE (Circle One):		
<u>Submersible</u>	Turbine,	Jet
Other (Describe) _____		
POWER TYPE (Circle One):		
<u>Electric</u>	Tractor,	Diesel,
Other (Describe) _____		Gasoline, $\frac{1}{2}$ Butane,
		H/P <u>$\frac{1}{2}$</u>
Pump Capacity (GPM)	No. of Stages	Setting Depth
<u>16</u>	<u>14</u>	<u>105</u> ft.
PUMP TEST		
Well yielded <u>16</u> GPM with		
a drawdown of <u>0</u> ft.		
after <u>1</u> hours of pumping		

WELL DATA		
Well Depth 110 ft.	Casing Diameter (In.) 4 in. 4.5 in.	Casing Length (Ft.) 90 ft.
Type of Casing PVC	Hole Depth 120 ft.	Depth to Static Water Level 65 ft.
TYPE OF COMPLETION: (Circle One or More): <u>Gravel Packed</u> , Underreamed, Telescoped, Natural Development, Open Hole, Other (Describe) _____		
WELL GROUTED TO A DEPTH OF <u>10</u> FEET Type Grout (circle one): Cement, Bentonite, or <u>Mix</u>		

LOG DATA	
TYPE OF LOG RUN (Circle One):	<u>No Log Run</u>
Electric, Gamma Ray, Density, Sonic, Neutron, Other (Describe) _____	
Name of Organization Running Log _____	

SCREEN DATA		
Diameter - Inches 4 in.	Length - Feet 20 ft.	Slot Size - Inches .010
Screen Type PVC		Depth to Bottom - Feet 110 ft.

GEOLOGIC DATA (Office Use Only)			
Surface Elev.	Geologic Unit	Unit Thickness	Depth to Top
Subs. SWL	Date	Analysis	Aquifer Test
Driller's Remarks			
Top of Lap Pipe or Reduction in Casing			
FEET		IF TELESKOPED OR MORE THAN ONE SCREEN: USE BACK PAGE	


[illegible]

FORM NO. 10 (REV. 10-1-80)

FROM	TO
RECEIVED	
MAR 15 1995	
Dept. of Environmental Quality Office of Land & Water Resources	
IF MORE SPACE IS NEEDED, USE BACK	

If well telescopes please
sketch and show depths.

GROUND LEVEL

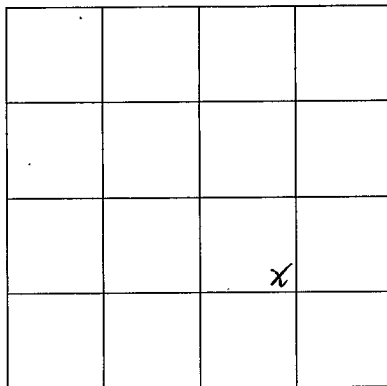

SECTION 4

Please indicate well location X.

ADDITIONAL INFORMATION

If more than one screen,
show location of each on sketch.