

**MISSISSIPPI DEPARTMENT OF ENVIRONMENTAL QUALITY**

Office of Land and Water Resources

P. O. Box 10631  
Jackson, MS 39289-0631  
**WATER WELL DRILLERS LOG**

COUNTY WELL LOCATED  
Licoles

WELL NUMBER R-2004 CODED

DATE WELL COMPLETED  
2-28-02

PERMIT NUMBER

NAME OF DRILLING FIRM  
Fitzgerald Well Service

NAME & MAILING ADDRESS OF LANDOWNER  
Lex Cook

McDonough Rd.

Latitude:  
Longitude:

WELL LOCATION. SEC 33 TOWNSHIP 5 RANGE 9

DISTANCE 4 MILES DIRECTION SW NEAREST TOWN Boschita

OTHER LANDMARK

WELL PURPOSE  Home,  Irrigation,  Municipal,  Industrial,  Fish Pond, etc.

**PUMP DATA**

PUMP TYPE (Circle One):  
 Submersible Turbine, Jet, Flowing Well.  
Other (Describe)

POWER TYPE (Circle One):  
 Electric Tractor, Diesel, Gasoline, Butane.  
Other (Describe) H/P 1/2

DESCRIPTION OF FORMATIONS ENCOUNTERED	FROM	TO
<u>clay</u>	<u>0</u>	<u>30</u>
<u>sand</u>	<u>30</u>	<u>40</u>
<u>sand &amp; gravel</u>	<u>40</u>	<u>80</u>
<u>clay</u>	<u>80</u>	<u>90</u>
<u>sand</u>	<u>90</u>	<u>100</u>
<u>course sand &amp; gravel</u>	<u>100</u>	<u>115</u>

**RECEIVED**

**MAR 12 2002**

**BY: OLWR**

Top of Lap Pipe or Reduction in Casing

**FEET** IF TELESCOPED OR MORE THAN ONE SCREEN: USE BACK PAGE

**WELL DATA**

Well Depth <u>115'</u>	Casing Diameter (In.) <u>4"</u>	Casing Length (Ft.) <u>105'</u>
Type of Casing <u>PVC</u>	Hole Depth <u>115'</u>	Depth to Static Water Level <u>69'</u>

TYPE OF COMPLETION: (Circle One or More):  
 Gravel Packed,  Underreamed,  Telescoped,  
 Natural Development,  Open Hole,  Other

WELL GROUTED TO A DEPTH OF 10 FEET  
Type Grout (circle one): Cement, Bentonite, or  Mix

**SCREEN DATA**

Diameter - Inches <u>4"</u>	Length - Feet <u>10'</u>	Slot Size - Inches <u>.012</u>
Screen Type <u>PVC</u>	Depth to Bottom - Feet <u>115'</u>	

I certify that the well was drilled, constructed and completed in accordance with all applicable Requirements of the Mississippi Department of Environmental Quality and/or the Mississippi Department of Health regulations and state laws.


Brod Fitzgerald 029  
Signature of Licensed Driller and License No.

2-28-02  
Date

Additional Information Required On Back

If well telescopes please sketch and show depths.

GROUND LEVEL

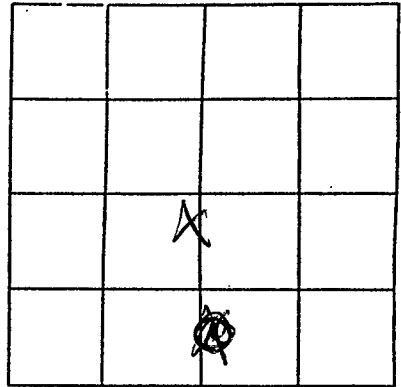

SECTION 33

Please indicate well location X.

Pump Capacity (GPM)	No. of Stages	Setting Depth
12	8	100' FT.

PUMP TEST

Well yielded \_\_\_\_\_ GPM with  
 a drawdown of \_\_\_\_\_ ft.  
 after \_\_\_\_\_ hours of pumping

LOG DATA

TYPE OF LOG RUN (Circle One):  No Log Run,  Electric,  Gamma Ray,  Density,  Sonic,  Neutron,  Other (Describe) \_\_\_\_\_

Name of Organization Running Log \_\_\_\_\_

GEOLOGIC DATA (Office Use Only)

Surface Elev.	Geologic Unit	Unit Thickness	Depth to Top
Subs. SWL	Date	Analysis	Aquifer Test

Driller's Remarks

\_\_\_\_\_  
 \_\_\_\_\_  
If more than one screen, show location of each on sketch.