

LOWNDES
A 24
S-25-71

MISSISSIPPI
BOARD OF WATER COMMISSIONERS
416 North State Street
Jackson, Mississippi 39201

CODED

WATER WELL DRILLERS LOG

5/25 1971 ALBERT DRILLING CO. - LOWNDES
date well completed firm name county well located

LANDOWNER:
Mr. Buddy Powell
Columbus, Miss.
(mailing address)

description of formations encountered	from	to
CLAY	0	8
GRAVEL SAND	8	30
BLUE ROCK	30	45
SAND	45	95
MUCK	95	130
SAND	130	186

WELL LOCATION:
sec. 26 T. 26 R. 18 S.
8 1/2 miles N of Columbus
(distance) (direction) (nearest town)

WELL PURPOSE: HOME
(home, irrigation, municipal, industrial)

- WELL COMPLETION DATA:
- (1) diameter (inches) 4"
 - (2) total depth (feet) 186'
 - (3) static water level (feet) 12 ^{below}/_{above} top of ground.
 - (4) casing METAL 36 ft.
(material) (depth)
4" (size) if telescope see back.
 - (5) screen NONE
(length) (depth to top)
(size) (material)
 - (6) pump 1/2 (HP) (yield gpm)
ELECTRIC (type power)
 - (7) electric log _____
(yes or no)
(organization running log)
 - (8) how well bottom plugged open

CODED


JUN 28 1971

MISC. DD. OF
REGISTERED COUNTY
COMMISSIONER

DRILLERS REMARKS:

If well telescopes please sketch and show depths.

GROUND LEVEL

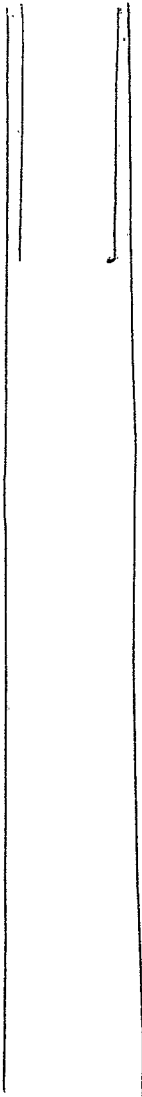

36'
4" METAL
CASING

15'
BLUE ROCK

186'
WELL

			X

SECTION _____

Please indicate well location X.

ADDITIONAL INFORMATION

If more than one screen,
show locations of each on sketch.