

CODED
CODED
 CODED

MISSISSIPPI
 BOARD OF WATER COMMISSIONERS
 416 North State Street
 Jackson, Mississippi 39201

WATER WELL DRILLERS LOG

Landowner
A26
3-69

March 19 69 Clardy Well Drilling Lowndes
 date well completed 45 Club firm name county well located

LANDOWNER: Bice Lancaster
 Hwy. 45 N.
 Columbus, Miss.
 (mailing address)

description of formations encountered	from	to
Top soil & Clay	0	10
Sand & gravel	10	50
Blue sand	50	60
Blue clay	60	65
Sandy blue clay	65	75
Sand	75	85
Blue clay	85	90
Fine sand	90	95
Sand & Clay streaks	95	105
Sand	105	125
Clay	125	130

WELL LOCATION:
 sec. 27 T. 16 N. R. 13 W.
8 miles N of Colo.
 (distance) (direction) (nearest town)

WELL PURPOSE:
 (home, irrigation, municipal, industrial)

WELL COMPLETION DATA:

(1) diameter (inches) 4"

(2) total depth (feet) 130

(3) static water level (feet) 18 below above top of ground.

(4) casing steel 70 1/2'
 (material) (depth)

 if telescope see back.
 (size)

(5) screen
 (length) (depth to top)

 (size) (material)

(6) pump
 (HP) (yield gpm)

 (type power)

(7) electric log
 (yes or no)

 (organization running log)

(8) how well bottom plugged

CODED


DRILLERS REMARKS:

MAR 11 1969

MISS. Bd. OF
 WATER COMMISSIONERS

If well telescopes please sketch and show depths.

GROUND LEVEL

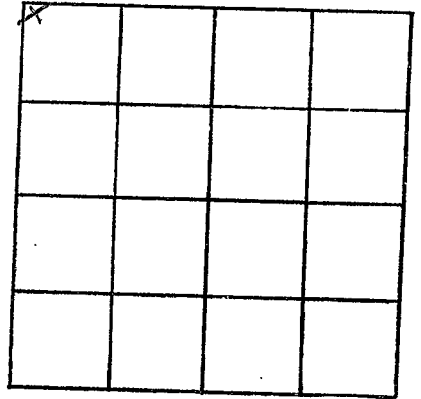

SECTION 27
22

Please indicate well location X.

ADDITIONAL INFORMATION

If more than one screen,
show locations of each on sketch.