

MISSISSIPPI
BOARD OF WATER COMMISSIONERS
416 North State Street
Jackson, Mississippi 39201

CODED

WATER WELL DRILLERS LOG

Lowndes
A 27
3-67

3-20 1967 W. J. REEVES & SON LOWNDES
date well completed firm name county well located

LANDOWNER: Mrs. J. R. Bostick
1209 3280608
1094 Southdown Parkway

description of formations encountered

from to

COLUMBUS
(mailing address)

CLAY	0	11
SAND & GRAVEL	11	28
BLUE CLAY	28	32
" SAND	32	39
" CLAY	39	53
" SAND	53	61
" CLAY	61	76
" SAND	76	94
" CLAY	94	103
" SAND	103	110

WELL LOCATION:


sec. 27 T. 16 R. 18
S W
10 miles No. of COLUMBUS
(distance) (direction) (nearest town)

WELL PURPOSE: MOTEL
(home, irrigation, municipal, industrial)

WELL COMPLETION DATA:

- diameter (inches) 4
- total depth (feet) 110
- static water level (feet) 9 below above top of ground.
- casing STEEL, 50'
(material) (depth)
4 if telescope see back.
(size)
- screen NONE
(length) (depth to top)
(size) (material)
- pump NONE
(HP) (yield gpm)
(type power)
- electric log No
(yes or no)
(organization running log)
- how well bottom plugged OPEN


CODED

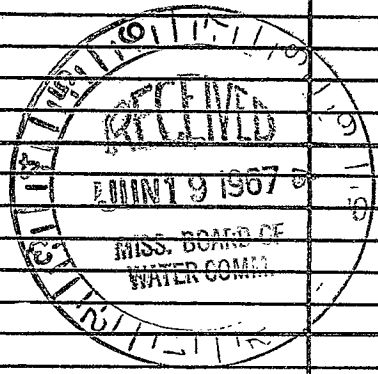

DRILLERS REMARKS:

If well telescopes please
sketch and show depths.

GROUND LEVEL

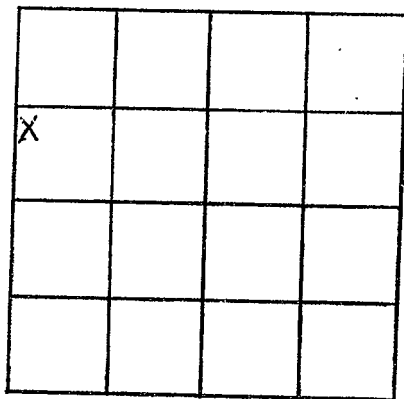

SECTION 27

Please indicate well location X.

ADDITIONAL INFORMATION

If more than one screen,
show locations of each on sketch.