

A31

WATER WELL DRILLERS LOG

CODED

A300

Date: 8-15-60 Aug 15, 1960, Driller: W. B. Clardy County Lowndes

8636-37 Hullett

(Name)

(1) Owner of Land: O. C. ~~Hullett~~

(Name)

Hwy 45 434 8452

(Address)

(2) Location: NE NENE 1/4, 1/4, Sec. 33 T16R18

10 miles no of Columbus

(distance) (direction) (Nearest Town)

(3) Topography: _____

(Hilly) (Flat) (Level)

(4) Purpose of Well: Domestic

(Domestic Irrigation
Municipal, Industrial, Other)

Description & Color of Materials Sand, Clay, Red Clay, Shell, etc.	Thick- ness Feet	Depth Feet
<u>Sand & gravel</u>	<u>3'</u>	<u>to 22'</u>
<u>blue Clay</u>	<u>22'</u>	<u>to 70'</u>
<u>Sand</u>	<u>70'</u>	<u>to 74'</u>
<u>Clay</u>	<u>74'</u>	<u>to 83'</u>
<u>Sand</u>	<u>83'</u>	<u>to 90'</u>
<u>Clay</u>	<u>90'</u>	<u>to 95'</u>
<u>Sand</u>	<u>95'</u>	<u>to 120'</u>

Information upon completion of well:

(1) Diameter 4 inches.

(2) Total Depth 125 feet.

(3) Water Level 7 feet below top of ground.

(4) Cased to 62'6", Size 4"

(5) Screen: Size _____, Length _____

(6) Were any formations sealed against pollution?


_____ yes, _____ no.

If YES depth of formation _____

Why _____

Drillers Remarks: _____

CODED

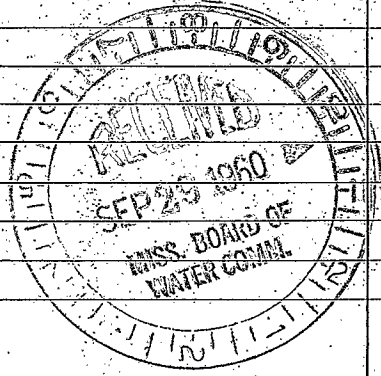

(Use Back Side)

Well No.
A300

