

MISSISSIPPI DEPARTMENT OF NATURAL RESOURCES

Bureau of Land and Water Resources

Southport Mall

P.O. Box 10631

Jackson, Mississippi 39209

WATER WELL DRILLERS LOG

TOM GRIFFITH

CODED

June 23 1983 PLUMBING & WELL SERVICE, INC. Lowndes  
 date well completed 320 MARYSON AVE. county well located  
 COLUMBIA, MS 39429

LANDOWNER: TXO Prod. Co

111 Capital Bldg, Suite 555

Jackson, MS

(mailing address)

WELL LOCATION:

sec. 30 T 16 N R 18 E

20 miles NE of Bay Springs, Ms.  
 (distance) (direction) (nearest town)

WELL PURPOSE: Oil location  
 (home, irrigation, municipal, industrial)

WELL COMPLETION DATA:

- (1) diameter (inches) 3"
- (2) total depth (feet) ~~430'~~ 430'
- (3) static water level (feet) 20' below top of ground.
- (4) casing steel, 310' (material) (depth)

N/A if telescope see back.  
 (size)

- (5) screen 40' (length), ~~390'~~ (depth to top)

3" slots (size) (material)

- (6) pump air lift, no (HP) (yield gpm)

air (type power)

- (7) electric log none (yes or no)


(organization running log)

- (8) how well bottom plugged welded

description of formations encountered	from	to
Heavy Gravel	0	30
Chalk	30	250
Sand	250	265
Chalk	265	380
Tight Pea Gravel	380	430
CODED		
#1 Columbus Air Base 2054' N + 1691' W of SE/COR SEC 30-16S-18W		
DEPT. OF NATURAL RESOURCES BUREAU OF LAND & WATER RESOURCES		
JUL 25 1983		
RECEIVED		
DRILLERS REMARKS:		

If well telescopes please sketch and show depths.

GROUND LEVEL

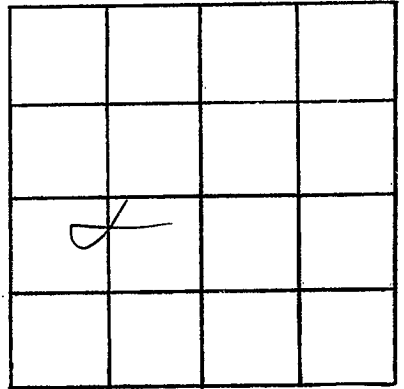

SECTION 30

Please indicate well location X.

ADDITIONAL INFORMATION

If more than one screen,  
show locations of each on sketch.