

LOWNDES
A 2002
2-25-79

MISSISSIPPI
 BOARD OF WATER COMMISSIONERS
 416 North State Street
 Jackson, Mississippi 39201

WATER WELL DRILLERS LOG

Feb 25 1979 Mid-South Drilling Louder
 date well completed firm name county well located

LANDOWNER: <u>Sam Bardwell</u>	description of formations encountered	from	to
<u>P.O. Box 1079</u>			
<u>Columbus, MS 39701</u> (mailing address)	<u>clay</u>	<u>0</u>	<u>15</u>
	<u>rock</u>	<u>15</u>	<u>20</u>
WELL LOCATION: ? sec. <u>19</u> T <u>18</u> R <u>17</u> ^{18W} _E <u>8</u> miles <u>NW</u> of <u>Columbus</u> (distance) (direction) (nearest town)	<u>clay</u>	<u>20</u>	
	<u>rock</u>	<u>240</u>	<u>255</u>
WELL PURPOSE: <u>home</u> (home, irrigation, municipal, industrial)	<u>clay & sand</u>	<u>255</u>	<u>390</u>

WELL COMPLETION DATA:

- (1) diameter (inches) 20 1/4
- (2) total depth (feet) 390 ft.
- (3) static water level (feet) 80 below top of ground.
- (4) casing PVC, 170,
 (material) (depth)
4 if telescope see back.
 (size)
- (5) screen no,
 (length) (depth to top)
3/4 (size) (material)
- (6) pump 3/4 10
 (HP) (yield gpm)
electric
 (type power)
- (7) electric log no
 (yes or no)
no
 (organization running log)
- (8) how well bottom plugged open

DRILLERS REMARKS:


Miss. Board of Water Comm.

MAY 29 1979

LIVED

If well telescopes please sketch and show depths.

GROUND LEVEL

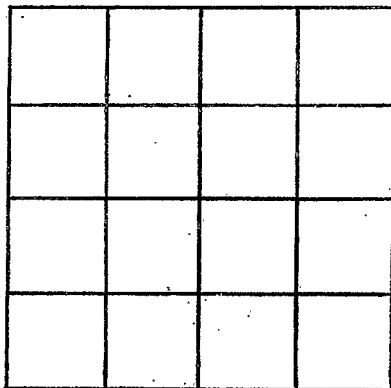

SECTION _____

Please indicate well location X.

ADDITIONAL INFORMATION

If more than one screen,
show locations of each on sketch.