

Received
DNR
9/24/79

MISSISSIPPI
BOARD OF WATER COMMISSIONERS
416 North State Street
Jackson, Mississippi 39201

Louides
A
2003
8-23-79
8-23
date well completed


WATER WELL DRILLERS LOG

1979 Mid South Drilling Louides
firm name county well located

LANDOWNER: <u>Jack Hamour</u>	description of formations encountered	from	to
<u>Columbus MS</u> (mailing address)	<u>clay</u>	<u>0</u>	<u>15</u>
WELL LOCATION: sec <u>23</u> T <u>16</u> R <u>18</u> <u>9</u> miles <u>N</u> of <u>Col.</u> (distance) (direction) (nearest town)	<u>sand & gravel</u>	<u>15</u>	<u>35</u>
WELL PURPOSE: <u>home</u> (home, irrigation, municipal, industrial)	<u>clay</u>	<u>35</u>	<u>135</u>
WELL COMPLETION DATA: (1) diameter (inches) <u>4</u>	<u>clay & sand</u>	<u>135</u>	<u>270</u>
(2) total depth (feet) <u>300</u>	<u>clay</u>	<u>270</u>	<u>275</u>
(3) static water level (feet) <u>15</u> <u>below</u> <u>above</u> top of ground.	<u>sand</u>	<u>275</u>	<u>300</u>
(4) casing <u>PVC</u> <u>153</u> (material) (depth) <u>4"</u> (size) if telescope see back.			
(5) screen <u>no</u> (length) (depth to top) (size) (material)			
(6) pump <u>no</u> (HP) (yield gpm) (type power)			
(7) electric log <u>no</u> (yes or no) <u>no</u> (organization running log)			
(8) how well bottom plugged <u>open</u>			
DRILLERS REMARKS:			

If well telescopes please sketch and show depths.

GROUND LEVEL

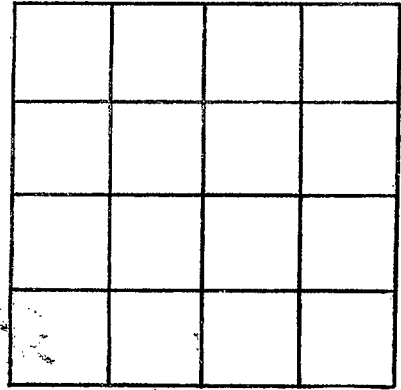

SECTION _____

Please indicate well location X.

ADDITIONAL INFORMATION

If more than one screen, show locations of each on sketch.