

MISSISSIPPI DEPARTMENT OF NATURAL RESOURCES

Bureau of Land and Water Resources

Southport Mall

P.O. Box 10631

Jackson, Mississippi 39209

WATER WELL DRILLERS LOG

LOWNDES
A 2004
11-7-80

11-7 1980 Bardy Well Drilling Lowndes
 date well completed firm name county well located

LANDOWNER: Norahy Skooten
Simon Lins Rd.
Caledonia, Miss.
 (mailing address)

description of formations encountered	depth	
	from	to
gravel & sand	18	34
blue clay	34	70
sandy clay	70	75
clay	75	92
sand	92	95
clay	95	105
sand	105	150

WELL LOCATION:
 sec. 27 T. 16 N. R. 18 E. S. 13 W. 1
8 1/2 miles N. of Calo.
 (distance) (direction) (nearest town)

WELL PURPOSE: home
 (home, irrigation, municipal, industrial)

WELL COMPLETION DATA:

- (1) diameter (inches) 4"
- (2) total depth (feet) 150
- (3) static water level (feet) 20' below above-top of ground.
- (4) casing PVC (material), (depth), (size) If telescope see back.
- (5) screen (length), (depth to top), (size), (material)
- (6) pump 1/2 (HP), 800 gpm (yield-gpm), E. Inc. (type power)
- (7) electric log No (yes or no), (organization running log)
- (8) how well bottom plugged _____

DRILLERS REMARKS:


DEPT. OF NATURAL RESOURCES
 BUREAU OF LAND & WATER RESOURCES

DEC - 8 1980

RECEIVED

If well telescopes please sketch and show depths.

GROUND LEVEL

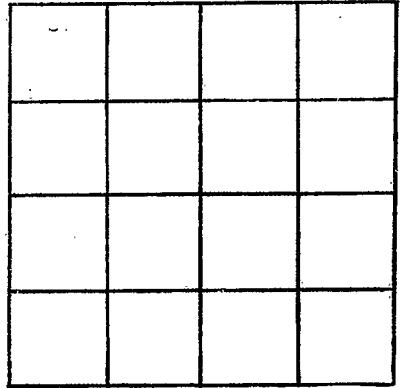

SECTION _____

Please indicate well location X.

ADDITIONAL INFORMATION

If more than one screen,
show locations of each on sketch.