

Lowndes
A 2008

MISSISSIPPI
 BOARD OF WATER COMMISSIONERS
 416 North State Street
 Jackson, Mississippi 39201

WATER WELL DRILLERS LOG

January 18, 19 83 Mid South Drilling Company Lowndes
 date well completed firm name county well located

LANDOWNER: <u>not known</u>	description of formations encountered	from	to
well drilled for Brooks & Field Construction (mailing address)			
	clay	0	15
	sand & gravel	15	43
	clay	43	60
	clay & sand	60	195
WELL LOCATION:			
sec. <u>22</u> T. <u>16</u> S. R. <u>18</u> W.			
<u>6</u> miles <u>NE</u> of <u>Columbus</u> (distance) (direction) (nearest town)			
WELL PURPOSE: <u>home</u> (home, irrigation, municipal, industrial)			
WELL COMPLETION DATA:			
(1) diameter (inches) <u>4</u>			
(2) total depth (feet) <u>195</u>			
(3) static water level (feet) <u>60</u> <u>below</u> above top of ground.			
(4) casing <u>PVC</u> <u>120</u> (material) (depth) <u>4"</u> If telescope see back. (size)			
(5) screen <u>n/a</u> (length) (depth to top) (size) (material)			
(6) pump <u>none</u> (HP) (yield gpm) (type power)			
(7) electric log <u>none</u> (yes or no) <u>no</u> (organization running log)			
(8) how well bottom plugged <u>open</u>			
DRILLERS REMARKS:			


DEPT. OF NATURAL RESOURCES
 BUREAU OF LAND & WATER RESOURCES

MAR 28 1983

RECEIVED

If well telescopes please sketch and show depths.

GROUND LEVEL

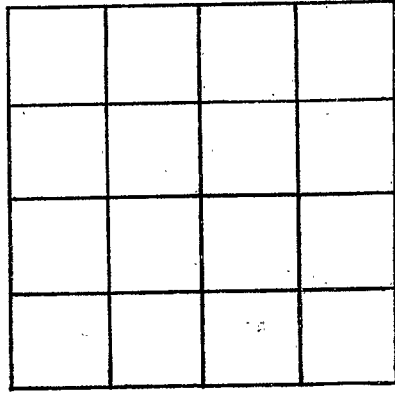

SECTION _____

Please indicate well location X.

ADDITIONAL INFORMATION

A series of horizontal lines for recording additional information, starting below the 'ADDITIONAL INFORMATION' header.

If more than one screen, show locations of each on sketch.