

MISSISSIPPI DEPARTMENT OF NATURAL RESOURCES

Bureau of Land and Water Resources

P.O. Box 10631

Jackson, Mississippi 39209

WATER WELL DRILLERS LOG

COUNTY WELL LOCATED Bounded	
WELL NUMBER A 2012	CODED
DATE WELL COMPLETED 1/12/96	

PERMIT NUMBER
NAME OF DRILLING FIRM Clardy Well Columbus, MS

NAME & MAILING ADDRESS OF LANDOWNER 14 SP22 / On W 3 Building 914 Columbus AFB, MS		
WELL LOCATION: SEC	TOWNSHIP	RANGE
21	16 N	18 E
DISTANCE	DIRECTION	NEAREST TOWN
8 1/2 Miles	9	Columbus
OTHER LANDMARK		
WELL PURPOSE: Home, Irrigation, Municipal, Industrial, Fish Pond, etc. Dog Kennel		

PUMP DATA		
PUMP TYPE (Circle One): Submersible , Turbine, Jet, Flowing Well, Other (Describe)		
POWER TYPE (Circle One): Electric , Tractor, Diesel, Gasoline, Butane, Other (Describe) H/P 3/4		
Pump Capacity (GPM) 900	No. of Stages 12	Setting Depth 70 FT.
PUMP TEST Well yielded _____ GPM with a drawdown of _____ ft. after _____ hours of pumping		

WELL DATA		
Well Depth 116.2	Casing Diameter (In.) 4"	Casing Length (Ft.) 79 1/2
Type of Casing PVC	Hole Depth	Depth to Static Water Level 12 1/2'
TYPE OF COMPLETION: (Circle One or More): Gravel Packed, Underreamed, Telescoped, Natural Development, Open Hole, Other (Describe)		
Top of Lap Pipe or Reduction in Casing		
IF TELESCOPED OR MORE THAN ONE SCREEN: USE BACK PAGE		

LOG DATA	
TYPE OF LOG RUN (Circle One): No Log Run, Electric, Gamma Ray, Density, Sonic, Neutron, Other (Describe)	
Name of Organization Running Log	


SCREEN DATA		
Diameter - Inches 2"	Length - Feet 40'	Slot Size - Inches .013
Screen Type PVC		Depth to Bottom - Feet

GEOLOGIC DATA (Office Use Only)			
Surface Elev.	Geologic Unit	Unit Thickness	Depth to Top
Subs. SW	Date	Analysis	Aquifer Test
Driller's Remarks FEB 08 1996			
Dept. of Environmental Quality Office of Land & Water Resources			

DESCRIPTION OF FORMATIONS ENCOUNTERED	FROM	TO	FORMATIONS (Continued)	FROM	TO
Sand + gravel	0	39			
Blue clay	39	56			
Rocky sandy clay	56	68			
Blue clay	68	75 1/2			
sandy clay	75 1/2	85			
clay	85	95			
sandy clay	95	96			
sand streak	96	120			
clay	120	150			
Rocky clay	150	162			

IF MORE SPACE IS NEEDED, USE BACK

If well telescopes please sketch and show depths.

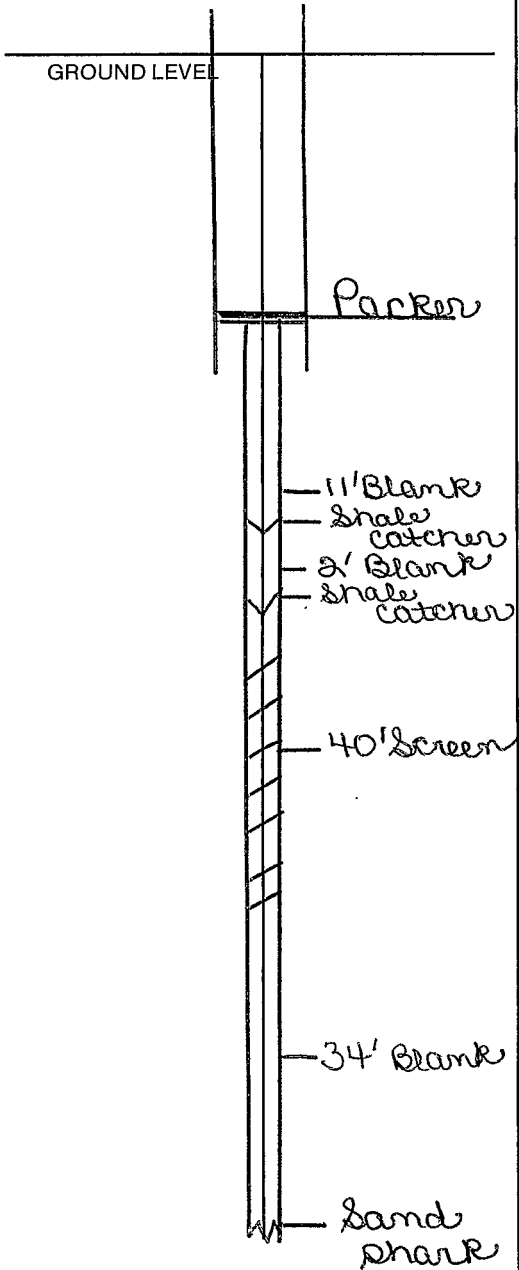

SECTION _____

Please indicate well location X.

ADDITIONAL INFORMATION

If more than one screen, show location of each on sketch.