

RECORDED
INDEXED

DEC 18 1968

MISS. BD. OF
WATER COMM.

Laundes
B 31
7-8-68

MISSISSIPPI
BOARD OF WATER COMMISSIONERS
416 North State Street
Jackson, Mississippi 39201

WATER WELL DRILLERS LOG

7-8-1968 date well completed
Martin S. Riggsby firm name
Laundes county well located

LANDOWNER: Jim Mills
California Miss

| description of formations encountered | from | to |
|---------------------------------------|------|-----|
| clay | 0 | 19 |
| Sand & gravel | 19 | 50 |
| clay | 50 | 98 |
| Sand | 98 | 165 |
| Clay | 165 | 225 |
| Sand | 225 | 275 |

(mailing address)

WELL LOCATION:

sec. 24 T. 15 N R. 17 E
8 miles NE of California
(distance) (direction) (nearest town)

WELL PURPOSE: farm
(home, irrigation, municipal, industrial)

WELL COMPLETION DATA:

- (1) diameter (inches) 4"
- (2) total depth (feet) 275'
- (3) static water level (feet) 190 below top of ground.
- (4) casing Steel 4" (material), 265' (depth)

if telescope see back.
(size)

- (5) screen 6' (length), 6' (depth to top)
- 2 (size), bronz (material)


- (6) pump 1 (HP), 10 (yield gpm)
- shot (type power)

- (7) electric log (yes or no)

(organization running log)


- (8) how well bottom plugged

DRILLERS REMARKS:

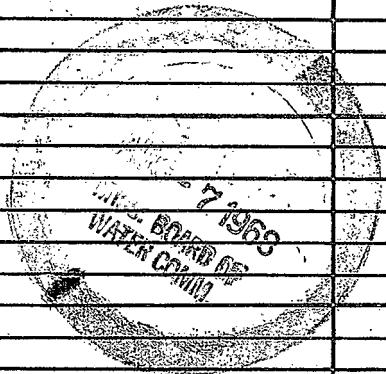

If well telescopes please sketch and show depths.

GROUND LEVEL

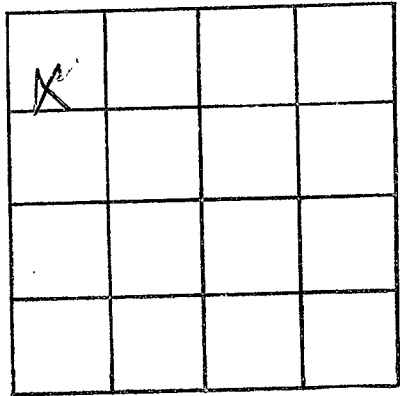

SECTION 24

Please indicate well location X.

ADDITIONAL INFORMATION

If more than one screen, show locations of each on sketch.