

CODED

MISSISSIPPI
BOARD OF WATER COMMISSIONERS
416 North State Street
Jackson, Mississippi 39201

LOWNDES
B 33
6-5-69

WATER WELL DRILLERS LOG

COLUMBUS WELLS DRILLING & DIGGING SER.

420 IDLEWILD

COLUMBUS, MISSISSIPPI 39701

6-5-69 19
date well completed

firm name

Lowndes
county well located

LANDOWNER: Larry Welch

Route 1

Caledonia, Miss.

(mailing address)

WELL LOCATION:

sec 35 T 15 N R 17 E

2.2 miles north of Columbus
(distance) (direction) (nearest town)

WELL PURPOSE:

(home, irrigation, municipal, industrial)

WELL COMPLETION DATA:

(1) diameter (inches) 4"

(2) total depth (feet) 170'

(3) static water level (feet) 70 below above top of ground.

(4) casing 31' (material) (depth)

(size) if telescope see back.

(5) screen none (length) (depth to top)

(size) (material)

(6) pump none (HP) (yield gpm)

(type power)

(7) electric log no (yes or no)

(organization running log)

(8) how well bottom plugged

DRILLERS REMARKS:


description of formations encountered	from	to
Solid Blue Clay	25'	50
Soft Blue clay	50'	55
Fine sand	55	63
Soft clay	63	65
Rocky strata	65	67
Solid Blue Clay	67	105
Thin Coarse sand	105	126
Soft blue clay	126	131
Rocky strata	131	132
Soft blue clay	132	134
Solid Blue Clay	134	141
Rocky strata	141	143
Solid blue clay	143	148
Coarse sand	148	170

SEP 3 1969

MISS. DE. OF WATER CONTROL

If well telescopes please sketch and show depths.

GROUND LEVEL

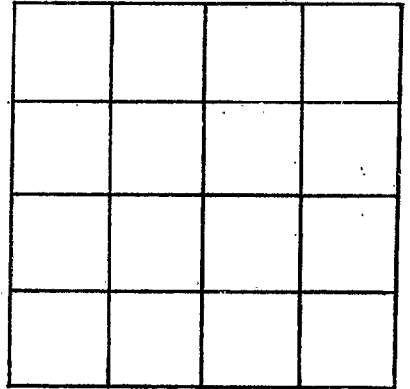

SECTION _____

Please indicate well location X.

ADDITIONAL INFORMATION

If more than one screen,
show locations of each on sketch.