

LOWNDES
B 34
6-13-69

MISSISSIPPI
BOARD OF WATER COMMISSIONERS
416 North State Street
Jackson, Mississippi 39201

CODED

WATER WELL DRILLERS LOG

6-13-69 19 Columbus Well Drilling Lowndes
date well completed firm name county well located

LANDOWNER: James R. Collins
Caledonia, Miss.
(mailing address)

description of formations encountered	from	to
Blue clay & Shell	43	155
Fine Sand	155	165
Good Sand	165	198
Blue Clay	198	200

WELL LOCATION:
sec. 9 T. 15 N R. 17 E
S W
2 3/4 miles NW of Caledonia
(distance) (direction) (nearest town)

WELL PURPOSE: Home
(home, irrigation, municipal, industrial)

WELL COMPLETION DATA:

(1) diameter (inches) 4"

(2) total depth (feet) 200 feet

(3) static water level (feet) _____ below above top of ground.

(4) casing Steel 55'
(material) (depth)
_____ if telescope see back.
(size)

(5) screen _____ (length) _____ (depth to top)
(size) (material)

(6) pump _____ (HP) _____ (yield gpm)
(type power)

(7) electric log _____ (yes or no)
(organization running log)

(8) how well bottom plugged _____


DEC - 1 1969

DRILLERS REMARKS:

MISS. BD. OF WATER COMM.

If well telescopes please sketch and show depths.

GROUND LEVEL

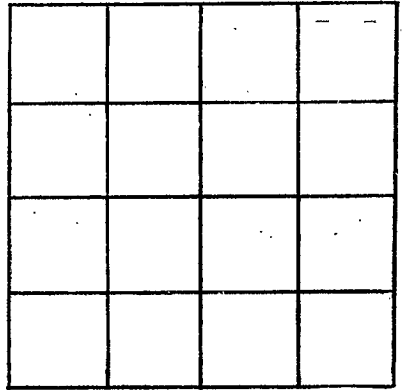

SECTION _____

Please indicate well location X.

ADDITIONAL INFORMATION

If more than one screen,
show locations of each on sketch.