

CODED

MISSISSIPPI  
 BOARD OF WATER COMMISSIONERS  
 416 North State Street

Jackson, Mississippi 39201

*Columbus Well Drilling & Digging Service*  
**WATER WELL DRILLERS LOG**

420 IDLEWILD  
 COLUMBUS, MISSISSIPPI 39701

LOWNDES  
B 35  
9-23-69

9-23-69 19  
 date well completed

firm name

county well located

LANDOWNER: Leon Hammill

description of formations encountered

from to

Caledonia, Miss  
 (mailing address)

WELL LOCATION:

sec. 8 T. 15 N. R. 17 E.  
2 miles NW of Caledonia  
 (distance) (direction) (nearest town)

top soil + clay	0	10
sand + gravel	10	20
blue clay	20	35
st. sand blue clay	35	60
blue clay	60	115
sand	115	117
blue clay	117	145
white clay	145	170
sand	170	220

WELL PURPOSE: home farm  
 (home, irrigation, municipal, industrial)

WELL COMPLETION DATA:

- (1) diameter (inches) 4"
- (2) total depth (feet) 220
- (3) static water level (feet) \_\_\_\_\_ below above top of ground.
- (4) casing Steel, 67'  
 (material) (depth)  
 \_\_\_\_\_ if telescope see back.  
 (size)
- (5) screen \_\_\_\_\_  
 (length) (depth to top)  
 \_\_\_\_\_  
 (size) (material)
- (6) pump 1 1/2 1000  
 (HP) (yield gpm)  
200 ✓  
 (type power)
- (7) electric log \_\_\_\_\_  
 (yes or no)  
 \_\_\_\_\_  
 (organization running log)
- (8) how well bottom plugged open


DRILLERS REMARKS:

DEC 1 1969

MISS. BD. OF  
 WATER COMMISSIONERS

If well telescopes please sketch and show depths.

GROUND LEVEL

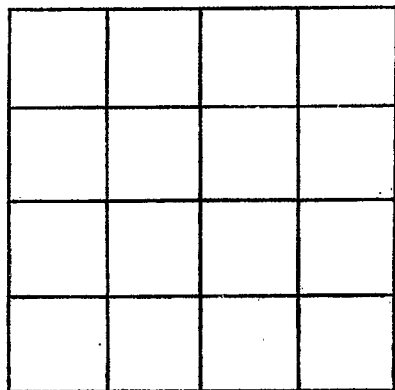

SECTION \_\_\_\_\_

Please indicate well location X.

ADDITIONAL INFORMATION

If more than one screen, show locations of each on sketch.