

Lowndes
B-38
8/18/71

MISSISSIPPI
 BOARD OF WATER COMMISSIONERS
 416 North State Street
 Jackson, Mississippi 39201

CODED

WATER WELL DRILLERS LOG

8/18 1971 W. Allsot Drilling Co. LOWNDES
 date well completed firm name county well located

LANDOWNER:
Clinton Nichols
Columbus, Miss.
 (mailing address)

WELL LOCATION:
 sec. 28 T. 16 N. R. 17 E
 S W
6 miles N. E of Columbus
 (distance) (direction) (nearest town)

WELL PURPOSE: HOME
 (home, irrigation, municipal, industrial)

WELL COMPLETION DATA:

(1) diameter (inches) 4"

(2) total depth (feet) 278

(3) static water level (feet) 20' below top of ground.

(4) casing METAL, 46'
 (material) (depth)

_____ if telescope see back.
 (size)

(5) screen _____
 (length) (depth to top)

_____ (size) _____ (material)

(6) pump 1/2 Sub 11
 (HP) (yield gpm)

ELECTRIC
 (type power)

(7) electric log No
 (yes or no)

_____ (organization running log)

(8) how well bottom plugged _____

description of formations encountered	from	to
TOP SOIL	0	42
BLUE ROCK	42	75
1st SAND	75	135
MUCK	135	215
WATER SAND	215	278

CODED


SEP 21 1971

DRILLERS REMARKS:

MISS. Bd. of
 WATER COMMISSIONERS

If well telescopes please sketch and show depths.

GROUND LEVEL

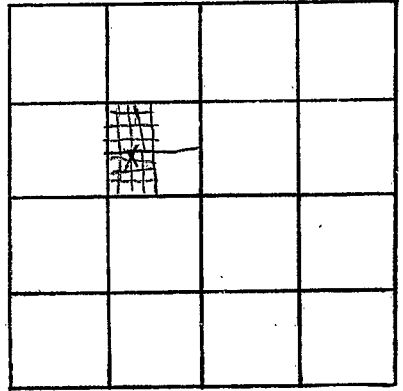

SECTION 28

Please indicate well location X.

ADDITIONAL INFORMATION

If more than one screen, show locations of each on sketch.