

LOWNDES
B 41
11-6-72

MISSISSIPPI
 BOARD OF WATER COMMISSIONERS
 416 North State Street
 Jackson, Mississippi 39201

CODED

WATER WELL DRILLERS LOG

11-6 1972 W.S. REEVES & SON LOWNDES
 date well completed firm name county well located

LANDOWNER: PAUL SANSING
CALEDONIA

description of formations encountered

from to

CLAY	0	17
RED SAND	17	25
BLUE CLAY	25	91
WHITE SAND & CLAY	90	120

(mailing address)

WELL LOCATION:

sec. 12 T. 16 N. R. 17 E
 S W
3 miles E of CALEDONIA
 (distance) (direction) (nearest town)

WELL PURPOSE: HOME
 (home, irrigation, municipal, industrial)

WELL COMPLETION DATA:

- diameter (inches) 4
- total depth (feet) 120
- static water level (feet) 78 below above top of ground.
- casing PVC, 100
 (material) (depth)
4 if telescope see back.
 (size)
- screen 20, 100
 (length) (depth to top)
4, PVC
 (size) (material)
- pump _____
 (HP) (yield gpm)
 (type power)
- electric log NO
 (yes or no)
 (organization running log)
- how well bottom plugged WOOD


CODED

REV. 1 - 1972
 TLO 10/1/72

DRILLERS REMARKS:

If well telescopes please sketch and show depths.

GROUND LEVEL

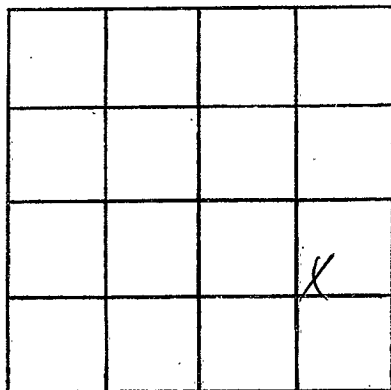

SECTION 12

Please indicate well location X.

ADDITIONAL INFORMATION

If more than one screen,
show locations of each on sketch.