

LOWNDES

B46

2/79

MISSISSIPPI
 BOARD OF WATER COMMISSIONERS
 416 North State Street
 Jackson, Mississippi 39201
 WATER WELL DRILLERS LOG

CODED

February 19 79 Herndon Well & Supply, Inc. Lowndes
 date well completed firm name county well located

LANDOWNER: Caledonia Water Ass	Description of formations encountered	from	to
Well #2, Caledonia, MS 39740	Brown Clay	0	5
	Clay Gravel	5	10
	Gravel	10	20
(mailing address)	Blue Clay	20	28
WELL LOCATION:	Coarse Yellow Sand & Gravel	28	32
sec. 16 T16 N S R 17 E W	Blue Clay	32	46
Inside the City Limits	Sandy Blue Clay	46	58
(distance) miles (direction) of (nearest town)	Blue Clay	58	124
WELL PURPOSE: Municipal (home, irrigation, municipal, industrial)	Sand	124	151
WELL COMPLETION DATA:	Blue Clay	151	255
(1) diameter (inches) 8 x 4	Pink Gumbo	255	275
(2) total depth (feet) 339'	Gravel	275	380
(3) static water level (feet) 128' below top of ground.			
(4) casing Steel 300' (material) (depth)			
8" (size) if telescope see back.			
(5) screen 41' 298' (length) (depth to top)			
4" Stainless (size) (material)			
(6) pump 15 190 (HP) (yield gpm)			
Electric (type power)			
(7) electric log yes (yes or no)			
U. S. Geological Survey (organization running log)			
(8) how well bottom plugged 4" BWV			
DRILLERS REMARKS:			

CODED


Miss. Board of Water Comm.

FEB 16 1979

RECEIVED

(X)

If well telescopes please sketch and show depths.

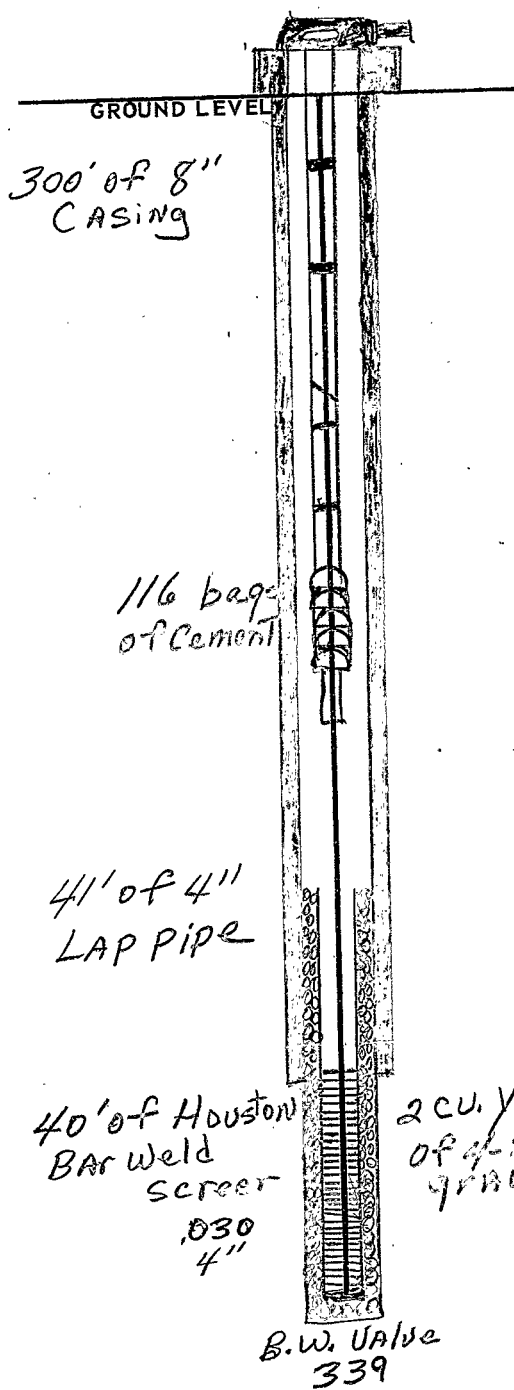

		X	

SECTION 16

Please indicate well location X.

ADDITIONAL INFORMATION

If more than one screen, show locations of each on sketch.