

LOWNDES  
B47  
7-1-79

MISSISSIPPI  
BOARD OF WATER COMMISSIONERS  
416 North State Street  
Jackson, Mississippi 39201

WATER WELL DRILLERS LOG

CODED

7-1-79 Griner Drilling Lowndes  
date well completed firm name county well located

LANDOWNER:	description of formations encountered	from	to
Elf Aquitaine Oil & Gas	Gravel + sand	0	42
	clay, gravel, sand	42	64
(mailing address)	gravel, sand	64	84
WELL LOCATION: 6115 S 115 W of	clay + sand	84	126
sec. 7 T. 15 N R. 17 E NE 1/4	clay	126	168
5 miles North of Columbus	clay + sand	168	190
(distance) (direction) (nearest town)	sand with couple small breakers	190	245
WELL PURPOSE: oil field supply	clay + gravel	245	260
(home, irrigation, municipal, industrial)			
WELL COMPLETION DATA:			
(1) diameter (inches) 6 3"			
(2) total depth (feet) 260'			
(3) static water level (feet) 70' below top of ground			
(4) casing steel 242' (material) (depth)			
3" If telescope see back. (size)			
(5) screen 42 200' (length) (depth to top)			
3" perforated (size) (material)			
(6) pump - 55 (HP) (yield gpm)			
AC (type power)			
(7) electric log (yes or no)			
(organization running log)			
(8) how well bottom plugged orange peat			
DRILLERS REMARKS:			


Miss. Board of Water Comm.

AUG 20 1979

RECEIVED

If well telescopes please  
sketch and show depths.

GROUND LEVEL

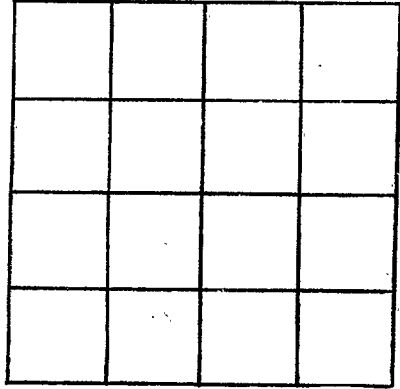

SECTION \_\_\_\_\_

Please indicate well location X.

ADDITIONAL INFORMATION

If more than one screen,  
show locations of each on sketch.