

Lowndes  
 B 48  
 10-22-79

MISSISSIPPI  
 BOARD OF WATER COMMISSIONERS  
 416 North State Street  
 Jackson, Mississippi 39201

CODED

WATER WELL DRILLERS LOG

10-22-79 date well completed  
 Griner Drilling Lowndes firm name  
 county well located

LANDOWNER:  
 Elf Aquitaine Oil  
 & Gas  
 (mailing address)

description of formations encountered	from	to
TOP SOIL & rock	0	21
gravel & sand	21	42
clay & rock	42	126
clay & rock	126	147
clay	147	168
clay - 5' of sand	168	189
18' of sand-clay	189	210
clay & sand 10'	210	231
sand, rock, clay	231	252
sand, clay, rock	252	297

WELL LOCATION: 1500'S + 1500'E  
 sec 4 T 16 N R 17 E of  
 Caledonia  
 N. of Columbus  
 (distance) (direction) (nearest town)

WELL PURPOSE: oil field supply  
 (home, irrigation, municipal, industrial)

- WELL COMPLETION DATA: 3"
- (1) diameter (inches) 3"
  - (2) total depth (feet) 297'
  - (3) static water level (feet) 105' below top of ground
  - (4) casing steel 273' (material) (depth)  
 3" (size) if telescope see back.
  - (5) screen 42' 231' (length) (depth to top)  
 3" perforated (size) (material)
  - (6) pump 50 (HP) (yield gpm)  
 AC (type power)
  - (7) electric log (yes or no)
  - (organization running log)
  - (8) how well bottom plugged peel orange


DRILLERS REMARKS:

DEPT. OF NATURAL RESOURCES  
 BUREAU OF LAND & WATER RESOURCES

NOV 13 1979  
 RECEIVED

If well telescopes please sketch and show depths.

GROUND LEVEL

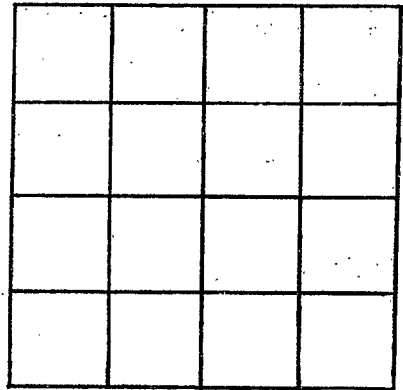

SECTION \_\_\_\_\_

Please indicate well location X.

ADDITIONAL INFORMATION

If more than one screen,  
show locations of each on sketch.