

Lowndes
B 49
10/20/80

MISSISSIPPI
BOARD OF WATER COMMISSIONERS ¹⁶ CODED
416 North State Street
Jackson, Mississippi 39201

WATER WELL DRILLERS LOG

Spiner Drilling Service, Inc *Lowndes*

10-20-80 date well completed firm name county well located

LANDOWNER:
Pruett Production
1515 Capital Towers
Jackson, MS 39205
(mailing address)

description of formations encountered	from	to
<i>clay, rock</i>	<i>0</i>	<i>273</i>
<i>rock</i>	<i>273</i>	<i>336</i>

WELL LOCATION: *060' N + 1860' W*
sec 25 T 15 N R 17 E of
Caledonia *SE 100'*
(distance) (direction) (nearest town)

<i>rock, gravel</i>	<i>336</i>	<i>359</i>
---------------------	------------	------------

WELL PURPOSE: *oil field*
(home, irrigation, municipal, industrial)

WELL COMPLETION DATA:

- (1) diameter (inches) *3"*
- (2) total depth (feet) *399'*
- (3) static water level (feet) *100'* *below* *above* top of ground.
- (4) casing *steel* *399'*
(material) (depth)
3"
(size) if telescope see back.
- (5) screen *42'* *357'*
(length) (depth to top)
3" *perforated*
(size) (material)
- (6) pump *60*
(HP) (yield gpm)
ac
(type power)
- (7) electric log *—*
(yes or no)
—
(organization running log)
- (8) how well bottom plugged *orange*
peel

DEPT. OF NATURAL RESOURCES
BUREAU OF LAND & WATER RESOURCES


OCT 23 1980

RECEIVED

DRILLERS REMARKS:

If well telescopes please sketch and show depths.

GROUND LEVEL

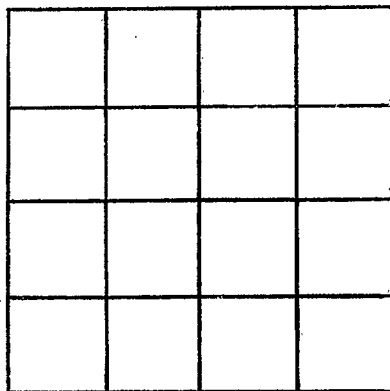

SECTION _____

Please indicate well location X.

ADDITIONAL INFORMATION

If more than one screen,
show locations of each on sketch.