

MISSISSIPPI DEPARTMENT OF NATURAL RESOURCES

Bureau of Land and Water Resources

Southport Mall

P.O. Box 10631

Jackson, Mississippi 39209

CODED

WATER WELL DRILLERS LOG

Griner Drilling Service, Inc.

Lowndes

LOWNDES
B 50
11-12-81

11-12-81 date well completed

Griner Drilling Service, Inc. firm name

Lowndes county well located

LANDOWNER:

Placid Oil Corporation  
Route 1, Box 117  
Gilbertown, Alabama

(mailing address) 36708

WELL LOCATION: 1500'S + 1620'W

sec. 33 T. 16 N. R. 17 E. NE1/4

No. 1 Woods Cooper Creek Field  
(distance) (direction) (nearest town)

WELL PURPOSE: oil field supply

(home, irrigation, municipal, industrial)

WELL COMPLETION DATA:

(1) diameter (inches) 3"

(2) total depth (feet) 357'

(3) static water level (feet) 100' <sup>below</sup> top of ground.

(4) casing steel 357' (material) (depth)

3" (size) if telescope see back.

(5) screen 42' 315' (length) (depth to top)

3" perforated (size) (material)

(6) pump AC 65 (HP) (yield gpm)

AC (type power)

(7) electric log (yes or no)

(organization running log)

(8) how well bottom plugged orange

peel

DRILLERS REMARKS:


description of formations encountered	from	to
clay, 5' of sand	0	203
clay	203	292
sand, gravel	292	357

CODED

DEPT. OF NATURAL RESOURCES  
BUREAU OF LAND & WATER RESOURCES  
DEC-9 1981  
RECEIVED

If well telescopes please sketch and show depths.

GROUND LEVEL

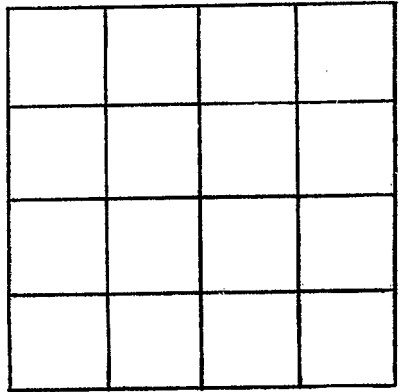

SECTION \_\_\_\_\_

Please indicate well location X.

ADDITIONAL INFORMATION

If more than one screen,  
show locations of each on sketch.