

MISSISSIPPI DEPARTMENT OF NATURAL RESOURCES

Bureau of Land and Water Resources

Southport Mall

P.O. Box 10631

CODED

Jackson, Mississippi 39209

WATER WELL DRILLERS LOG

Griner Drilling Service, Inc.

Lowndes

Lowndes
B51
5-31-82

5-31-82
date well completed

Griner Drilling Service, Inc.
firm name

Lowndes
county well located

LANDOWNER:
Pruett Production
1515 Capital Towers
Jackson, MS 39205
(mailing address)

description of formations encountered

from to

chalk, gravel

0 63

chalk

63 315

streaked

315 336

chalk, sand 10'

336 357

sand

357 420

WELL LOCATION: *1980'N & 1980'W*
sec. *21* T. *16* N. R. *17* E. S. *10* 01

No. 1 Caledonia
Robert McKles
miles (direction) (nearest town)

W. WELL PURPOSE: *oilfield supply*
(home, irrigation, municipal, industrial)

WELL COMPLETION DATA:

(1) diameter (inches) 3"

(2) total depth (feet) 420'

(3) static water level (feet) 70' below top of ground.

(4) casing Steel, 399'
(material) (depth)

3"
(size) if telescope see back.

(5) screen 42", 357'
(length) (depth to top)

3", perforated
(size) (material)

(6) pump —, 70
(HP) (yield gpm)

AC
(type power)

(7) electric log —
(yes or no)

(organization running log)

(8) how well bottom plugged orange

DRILLERS REMARKS:


DEPT. OF NATURAL RESOURCES
BUREAU OF LAND & WATER RESOURCES

JUN - 4 1982

RECEIVED

If well telescopes please sketch and show depths.

GROUND LEVEL

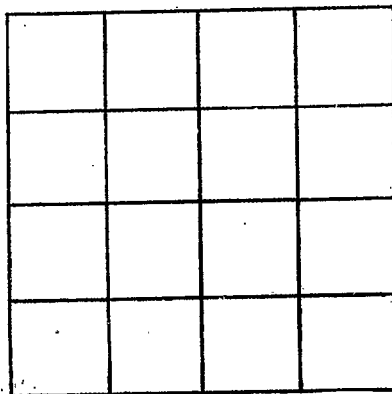

SECTION _____

Please indicate well location X.

ADDITIONAL INFORMATION

A series of horizontal lines for providing additional information, located below the 'ADDITIONAL INFORMATION' header.

If more than one screen, show locations of each on sketch.