

Lowndes
 B 52
 10/6/82

MISSISSIPPI DEPARTMENT OF NATURAL RESOURCES

Bureau of Land and Water Resources

Southport Mall

P.O. Box 10631

Jackson, Mississippi 39209

WATER WELL DRILLERS LOG

Griner Drilling Service, INC.

Lowndes

date well completed

firm name

county well located

LANDOWNER:

Pruet Production
 1515 Capital Towers
 Jackson, MS. 39205
 (mailing address)

description of formations encountered

from

to

gravel, clay

0

63

clay, rock

63

365

sand

365

390

clay, rock

390

441

WELL LOCATION: 188214 26001E

sec. 20 T 16 N R 17 SW 1/4

No. 1 Maple Branch Field
 1/2 mile (distance) of (direction) (nearest town)
 Egan

WELL PURPOSE:

oil field, supply

WELL COMPLETION DATA:

- (1) diameter (inches) 3"
 (2) total depth (feet) 420'
 (3) static water level (feet) 90' below top of ground.

- (4) casing steel 399'
 (material) (depth)
 3" (size) If telescope see back.

- (5) screen 42' 357'
 (length) (depth to top)
 3" perforated
 (size) (material)

- (6) pump 60-65
 (HP) (yield gpm)
 AC
 (type power)

- (7) electric log
 (yes or no)

(organization running log)

- (8) how well bottom plugged orange
 peel

DRILLERS REMARKS:

CODED


DEPT. OF NATURAL RESOURCES
 BUREAU OF LAND & WATER RESOURCES

OCT 25 1982

RECEIVED

If well telescopes please
sketch and show depths.

GROUND LEVEL

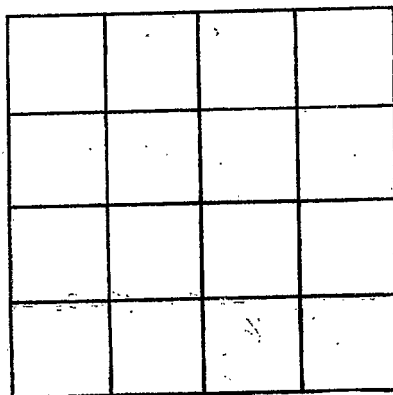

SECTION _____

Please indicate well location X.

ADDITIONAL INFORMATION

If more than one screen,
show locations of each on sketch.