	State Well Report	To come Her Only			
county: Soundes	Part 1 – Driller's Log	For Office Use Only:			
County: Mis	sissippi Department of Environmental Quality	Aquifer:			
Permit #:	Office of Land and Water Resources	Well #:			
Driller: Clardy Yulell	P.O. Box 2309 Jackson, MS 39225	1			
	(601)961- 5210	L. S. Elevation:			
Date drilling completed: 19 29 15	(601)961- 5228 (fax)	E-log #:			
State Law requires that this report be prepared by the license holder responsible for the work and filed with the Department at the above address within 30 days of completion of drilling of the well or borehole.					
Information on Well Owner	Well or	Borehole Location			
(Landowner if borehole is not for a w	latinde: 33 ° HO	12 Longitude: 088° 17 '335			
Owner Name Y Vullia Pice	R,				
	Method of Lat/Long (circle	ethod of Lat/Long (circle one): Conventional Survey,			
Mailing Address: 1950 Stone	Mailing Address: 1950 Stonley GPS				
Osos quad Hand-lied Oris, but to grant original		- 11.6 - 17W			
Mailing Address: Mailin					
City State	Zip Code Distance Direction	Nearest Town			
עום חווו וחד	Miles Fast	of Caledonia			
Telephone No. (Idea 364-175a					
Well / Borehole Data					
deals	L. L. HOOLE Haladamba IIan	Hole diameter:			
Date drilling started: 1034 15 Date drilling	completed: 10 29 15 Hole depth: 160	Tiole diameter.			
C C C Advilling:					
Method of dosing and volume of Chlorine used in drilling and development:					
Logs run (circle all applicable): No log run Electric Gamma Ray Density Sonic Neutron Other:					
Name of organization running log(s):					
Purpose of borehole (check one): Water Well Geotechnical/Geological Investigation Ground Source Heat Pump					
Seismic Survey Other (describe)					
If drilling is not related to water well construction, skip the remainder of this block					
Purpose of Well (check one): Home Industrial Public Supply Irrigation Fish Culture Other:					
If a flowing well, method of flow regulation: Valve Other (describe)					
Static Water Level: feet above or below (circle one) land surface					
Method of Measurement (circle one) steel tape electric tape air line other:					
Well depth: Well grouted to a depth of Officet Type of grout (circle one): Neat Cement Bentonite Mix					
Casing length:					
Screen length:					
Screen slot size:					
Type of completion (circle all applicable): Gravel packed Underreamed Telescoped Open hole Natural Development					

Other (describe):

Top of lap pipe or reduction in casing:


Form: OLWR-SWR-1A (04/08)
RECEIVED

feet. If telescoped or more than one screen, describe on next page

NOV 20 2015

BY: OLWR

Permit #:		For Office Use Only: Well #: P 70		Only:
The sketch below only require		Description of formations encountered and boreholes, unless specifically exen		
If well telescopes, show depth	s on skeich.	Description of Formations Encountered	From (depth)	To (depth)
Ground Level		Red Clay	Ground level	16
		sand & glavel	16	.32
		Blue clay	139	156
		Clay	156	160
	mod	Cong	137	100
	-1401 Blank	- U		
	Blank			
	1			
	- 20° Screen			
	Screen			
			-	
			 	
	†			
If more than one screen, show loc	cation of each on sketch			

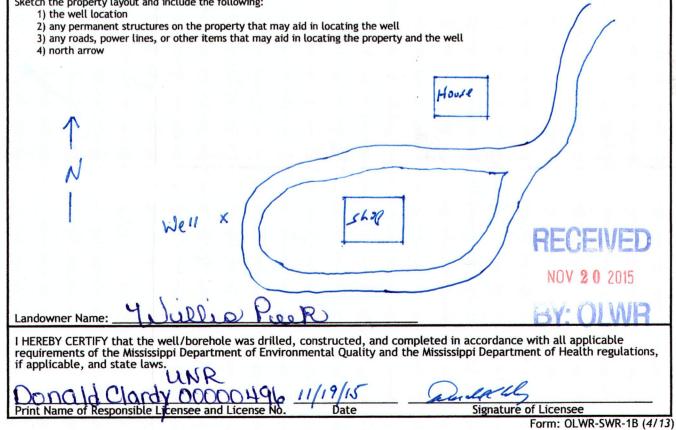

STATE WELL REPORT

County: Downdes Permit #: Driller: Clarde Date completed: Copy information from block on Part 1

Part 2

Pump Installer's Completion Report Mississippi Department of Environmental Quality Office of Land and Water Resources

P.O. Box 2309 Jackson, MS 39225-2309 (601)961-5210 (601) 360-0535 (fax)

For Office Use Only:		
Well #:	B70	
Aquifer:		

This part of the report must be completed by a licensed water of the report must be attached and both parts filed with the L	well contractor or a licensed pump installer. A copy of Part 1 Department at the above address within 30 days of well completion.				
Well Owner Information	Well Location				
Owner Name: Willia Peek	Latitude: 133°40642 Longitude: 088° 17335				
Mailing Address: 1950 StanleyRd.	Method of Lat/Long (check one): Conventional Survey,				
<u> </u>	USGS quad, Hand-held GPS, Survey-grade GPS				
Calodonia, The 39740 City State Zip Code	1¼1¼, Sec T R				
City State Zip Code Telephone No. ()	(Distance) Miles East of Cale doma (Nearest Town)				
Pump Type (circle one)					
Submersible Turbine Air Lift Centrifugal Flowing Well Jet Piston Rotary Other (describe):					
Date Pump Installed: Rated Pump Capacity: Gallons Per Minute					
Is This Pump (circle one): New Repaired Replacement					
Power Type (circle one)					
Electric Diesel Gasoline Natural Gas Tractor PTO Windmill Other (describe):					
Horse Power Rating of Motor: Setting Dept	th:feet Number of Stages:				
Pump Test Data for Non Flowing Well					
Date Well Tested: 10 30 15 Duration of Pump Test (minimum 4 hours):hours					
Static Water Level (A): Feet Below Land Surface Pumping Water Level (B): Feet Below Land Surface					
Drawdown [(B) - (A)]: Feet Below Land Surface Test Pumping Rate: Gallons Per Minute					
Method of measurement (circle one): Steel tape Electric tape Air line Other (describe):					
Pump Test Data for Flowing Well					
Measured shut in head:feet.					
Well yieldedGPM with a drawdown of	feet afterhours of pumping				
Meter Installation					
Meter Manufacturer:	Meter Serial Number:				
Meter Model Number/Name:	Type of Meter:				
Totalizer Register Unit and Multiplier Factor (AF x .001, gal x 1000, etc):					
Installation Date: Meter installed by:					
Is This Meter (circle one): New Repaired Replacement					
Important: By submitting the above information you are certifying that this meter was installed to manufacturer standards. For agricultural wells, a list of approved meters is on the MDE Q website.					
I HEREBY CERTIFY that the above statements are true to the best of my knowledge.					
Donald Clarent Common 4910 11/19/15 Dunal Mily					

Donald Clardy 0000 496
Print Name of Pump Installer and License No. (if applicable)

11/19/15

Signature of Pump Installer

Form: OLWR-SWR-2A (4/13)