

B

3-30-61

WATER WELL DRILLERS LOG

B300

Date: 3-30, 1961, Driller: W. J. REEVES, JR. County: LOWNOES

843

(Name)

(1) Owner of Land: CALEDONIA HEALTH CTR. (Name)	Description & Color of Materials Sand, Clay, Red Clay, Shell, etc.	Thick- ness Feet	Depth Feet
CALEDONIA, MISS- (Address)	RED CLAY	14	0
(2) Location: 1/4, 1/4, Sec. 9 T16R17, IN CITY miles of (direction) (Nearest Town)	SAND & GRAVEL	24	14
(3) Topography: HILLY (Hilly) (Flat) (Level)	BLUE CLAY	16	38
(4) Purpose of Well: DOMESTIC (Domestic Irrigation - Municipal, Industrial, Other)	WHITE SAND	20	54

Information upon completion of well:


- (1) Diameter 2 inches.
- (2) Total Depth 74 feet.
- (3) Water Level 35 feet below top of ground.
- (4) Cased to 59', Size 2"
- (5) Screen: Size 2", Length 15'
- (6) Were any formations sealed against pollution?  
\_\_\_\_\_ yes, \_\_\_\_\_ no.

If YES depth of formation \_\_\_\_\_

Why \_\_\_\_\_

Drillers Remarks: \_\_\_\_\_

WELL CASING CEMENTED FROM 0 TO 20 FEET BELOW SURFACE

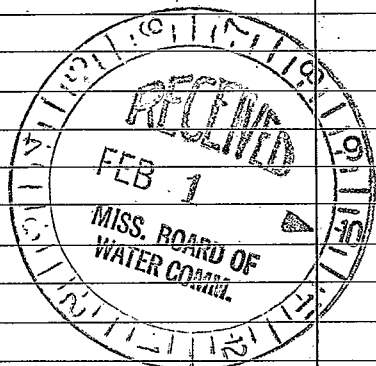

(Use Back Side)

Well No.

