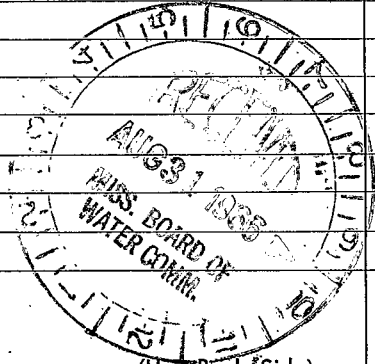


Lowndes  
B 2001  
7-66

MISSISSIPPI BOARD OF WATER COMMISSIONERS

WATER WELL DRILLERS LOG

Date: July, 1966, Driller: W.B. Clardy County Lowndes  
(Name)

(1) Owner of Land:	Description & Color of Materials Sand, Clay, Red Clay, Shell, etc.	Thick- ness Feet	Depth Feet
<u>G. F. Jones</u> (Name) <u>Star Rt.</u> (Address)	<u>Sand + gravel 10' - 28'</u>		
(2) Location: <u>1/4</u> , <u>1/4</u> , Sec. <u>20</u> T. <u>R</u> , <u>12</u> miles <u>N. 165</u> of <u>17W</u> (distance) (direction) (Nearest Town)	<u>Blue Clay 28'</u>		
(3) Topography: <u>Hilly</u> (Hilly) (Flat) (Level)	<u>Sand 105' - 110'</u>		
(4) Purpose of Well: <u>Domestic</u> (Domestic Irrigation Municipal, Industrial, Other)	<u>Sand 150' - 155'</u>		
Information upon completion of well:	<u>Sand 175' - 210'</u>		
(1) Diameter <u>4</u> inches.	<u>Streaks of Clay between sand.</u>		
(2) Total Depth <u>210</u> feet.			
(3) Water Level <u>50</u> feet below top of ground.			
(4) Cased to <u>83</u> , Size <u>4"</u>			
(5) Screen: Size _____, Length _____			
(6) Were any formations sealed against pollution? _____ yes, _____ no.			
If YES depth of formation _____			
Why _____			
Drillers Remarks: _____ _____ _____			

Well No.

