

Lowndes
 B 2002
 4-67

MISSISSIPPI
 BOARD OF WATER COMMISSIONERS
 416 North State Street
 Jackson, Mississippi 39201

WATER WELL DRILLERS LOG

4-28 1967 W.J. REEVES & SON LOWNDES
 date well completed firm name county well located

LANDOWNER: MRS. J.D. UMBERS

description of formations encountered

from to

RED

RED CLAY

0 12

CALEDONIA

" CLAY & GRAVEL

12 19

(mailing address)

" SAND

19 40

WELL LOCATION:

GREY CLAY

40 47

sec. 36 T. 15 S. R. 17 E. W.

RED SAND


47 66

4 miles NE of CALEDONIA
 (distance) (direction) (nearest town)

WELL PURPOSE: HOME
 (home, irrigation, municipal, industrial)

WELL COMPLETION DATA:


- (1) diameter (inches) 4
- (2) total depth (feet) 66
- (3) static water level (feet) 40 below top of ground.
- (4) casing PVC 46
 (material) (depth)
 4 (size) if telescope see back.
- (5) screen 20 46
 (length) (depth to top)
 4 PVC
 (size) (material)
- (6) pump NONE
 (HP) (yield gpm)
 (type power)
- (7) electric log NO
 (yes or no)
 (organization running log)
- (8) how well bottom plugged SAND

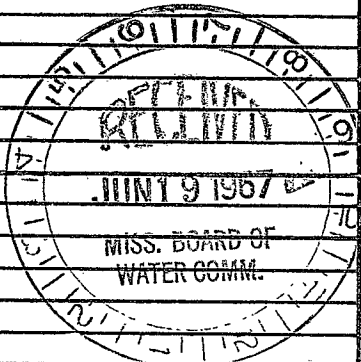

DRILLERS REMARKS:

If well telescopes please sketch and show depths.

GROUND LEVEL

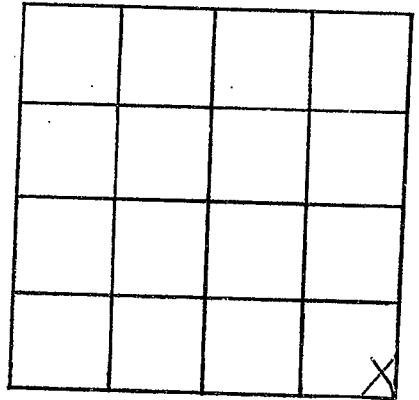

SECTION 35

Please indicate well location X.

ADDITIONAL INFORMATION

If more than one screen,
show locations of each on sketch.