

Lowder  
B 2003  
9-13-75

MISSISSIPPI  
 BOARD OF WATER COMMISSIONERS  
 416 North State Street  
 13L Jackson, Mississippi 39201

WATER WELL DRILLERS LOG

9-13 1975 W. J. REEVES SON Low N DES  
 date well completed firm name county well located

LANDOWNER: NELSON CHAIN  
1114 GARDNER BLVD.  
COL. UMBAS  
 (mailing address)

description of formations encountered	from	to
CLAY	0	16
RED SAND & GRAVEL	16	70
BLUE CLAY	70	128
BLUE CLAY & SAND	128	200

WELL LOCATION:  
 sec. 32 T 16 N R 17 E  
 S W  
4 miles S of CAVEDON  
 (distance) (direction) (nearest town)

WELL PURPOSE: HOME  
 (home, irrigation, municipal, industrial)


- WELL COMPLETION DATA:
- (1) diameter (inches) 4
  - (2) total depth (feet) 200
  - (3) static water level (feet) 45 below top of ground.
  - (4) casing PVC 80  
 (material) (depth)
  - 4 if telescope see back.  
 (size)
  - (5) screen NONE  
 (length) (depth to top)
  - (size) (material)
  - (6) pump 1/2 10  
 (HP) (yield gpm)
  - ELECT.  
 (type power)
  - (7) electric log NO  
 (yes or no)
  - (organization running log)
  - (8) how well bottom plugged OPEN

DRILLERS REMARKS:

MISSISSIPPI  
 BOARD OF WATER COMMISSIONERS  
 416 North State Street  
 JACKSON, MISSISSIPPI 39201

If well telescopes please sketch and show depths.

GROUND LEVEL

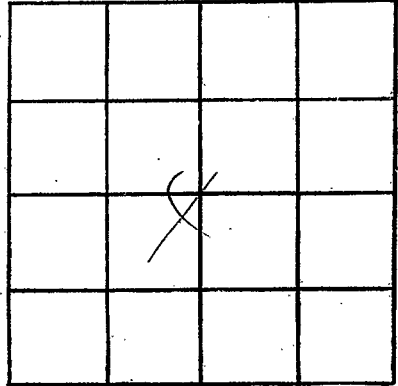

SECTION 32

Please indicate well location X.

ADDITIONAL INFORMATION

If more than one screen,  
show locations of each on sketch.