

LOWNDES  
B 2004  
9-16-75

MISSISSIPPI  
 BOARD OF WATER COMMISSIONERS  
 416 North State Street  
 Jackson, Mississippi 39201

WATER WELL DRILLERS LOG

9-16 1975 W. J. REEVES & SON LOWNDES  
 date well completed firm name county well located

LANDOWNER: NELSON CRAIN  
1114 CARDNER BLVD  
COLUMBUS  
 (mailing address)

description of formations encountered	from	to
CLAY	0	16
RED SAND & GRAVEL	16	72
BLUE CLAY	72	120
BLUE CLAY & SAND	120	200

WELL LOCATION:  
 sec. 32 T. 16 N. R. 17 W.  
 S. W.  
4 miles S of CALEDONIA  
 (distance) (direction) (nearest town)


WELL PURPOSE: HOME  
 (home, irrigation, municipal, industrial)

- WELL COMPLETION DATA:
- (1) diameter (inches) 4
  - (2) total depth (feet) 200
  - (3) static water level (feet) 45 below above top of ground.
  - (4) casing PVC 80  
 (material) (depth)
  - 4 If telescope see back.  
 (size)
  - (5) screen NONE  
 (length) (depth to top)
  - (size) (material)
  - (6) pump 1/2 10  
 (HP) (yield gpm)
  - ELECT  
 (type power)
  - (7) electric log NO  
 (yes or no)
  - (organization running log)
  - (8) how well bottom plugged OPEN

DRILLERS REMARKS:

If well telescopes please sketch and show depths.

GROUND LEVEL

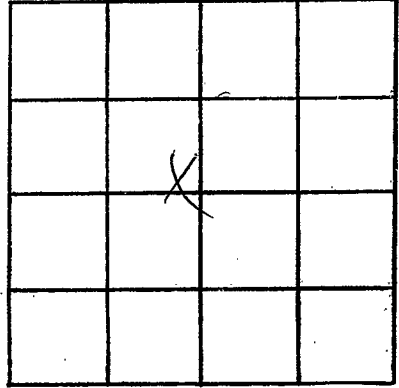

SECTION 32

Please indicate well location X.

ADDITIONAL INFORMATION

If more than one screen,  
show locations of each on sketch.