

MISSISSIPPI DEPARTMENT OF NATURAL RESOURCES

Bureau of Land and Water Resources

Southport Mall

P.O. Box 10631

Jackson, Mississippi 39209

WATER WELL DRILLERS LOG

TOM GRIFFITH

Lowndess

PLUMBING & WELL SERVICE, INC.

320 MAYSON AVE

county well located

Journal
B 2012

11-20-83
date well completed

LANDOWNER: Pruett Production

1515 Capital Towers

Jackson, MS
(mailing address)

WELL LOCATION:
sec 33 T 16 N R 17 E
5 miles SE of Calhounia
(distance) (direction) (nearest town)

WELL PURPOSE: Oil Location
(home, irrigation, municipal, industrial)

WELL COMPLETION DATA:

- (1) diameter (inches) 4"
- (2) total depth (feet) 270'
- (3) static water level (feet) 100' below top of ground.
- (4) casing PUC, 230'
(material) (depth)
N/A if telescope see back.
(size)
- (5) screen 40', 230'
(length) (depth to top)
4", PUC
(size) (material)
- (6) pump 3, 23
(HP) (yield gpm)
electric
(type power)
- (7) electric log NO
(yes or no)
N/A
(organization running log)
- (8) how well bottom plugged BWO

description of formations encountered	from	to
<u>Top soil</u>	<u>0</u>	<u>1</u>
<u>Gravel</u>	<u>1</u>	<u>20</u>
<u>Sand & Green Chalk</u>	<u>20</u>	<u>220</u>
<u>Coarse Sand & Black Spots</u>	<u>220</u>	<u>270</u>


DRILLERS REMARKS: Tight Sand
needed 50 GPM got
only 5 GPM

DEPT. OF NATURAL RESOURCES
BUREAU OF LAND & WATER RESOURCES

DEC 15 1983
RECEIVED

If well telescopes please sketch and show depths.

GROUND LEVEL

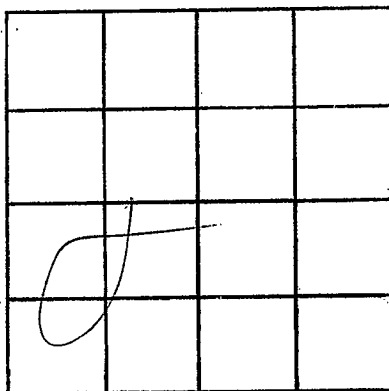

SECTION 33

Please indicate well location X.

ADDITIONAL INFORMATION

If more than one screen,
show locations of each on sketch.