

LOWNDES
 B 2020
 11-4-81

MISSISSIPPI
 BOARD OF WATER COMMISSIONERS
 416 North State Street
 Jackson, Mississippi 39201

WATER WELL DRILLERS LOG

11-4-81
 date well completed

1981 Martin S. Killpatrick
 firm name

Lowndes
 county well located

LANDOWNER: Mrs Bill Kitch

Caledonia MS.

(mailing address)

WELL LOCATION:

sec 34 T. 16 N R. 17 E
 S
 5 miles north of Steens
 (distance) (direction) (nearest town)

WELL PURPOSE: Home
 (home, irrigation, municipal, industrial)

WELL COMPLETION DATA:

- (1) diameter (inches) 4"
- (2) total depth (feet) 185'
- (3) static water level (feet) 80 below top of ground.
- (4) casing PVC 1.50' (material) (depth)
- (size) if telescope see back.
- (5) screen 25' 150' (length) (depth to top)
- 2" PVC (size) (material)
- (6) pump 1/2 5 (HP) (yield gpm)
- C (type power)
- (7) electric log NO (yes or no)

(organization running log)

(8) how well bottom plugged after

DRILLERS REMARKS:

description of formations encountered

from

to

clay	0	15
sand + gravel	15	27
gravel + clay	27	50
blue clay	50	100
sand	100	64
blue clay	64	76
sand	76	84
blue clay	84	148
sand - clay streaks	148	183


DEPT. OF NATURAL RESOURCES
 BUREAU OF LAND & WATER RESOURCES

NOV 30 1981

RECEIVED

If well telescopes please
sketch and show depths.

GROUND LEVEL

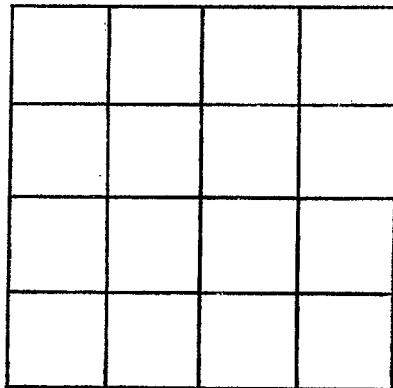

SECTION _____

Please indicate well location X.

ADDITIONAL INFORMATION

If more than one screen,
show locations of each on sketch.