

WATER WELL DRILLERS LOG

8-25-61

Date: Aug 25, 1961, Driller: W. B. Clark County Lowndes

(Name)

(1) Owner of Land: Davis (Name)

Hwy 45 - Spiney Rd (Address)

(2) Location: 1/4, 1/4, Sec. T. R.

6 miles no. of Cal. (distance) (direction) (Nearest Town)

(3) Topography: Hilly (Hilly) (Flat) (Level)

(4) Purpose of Well: Domestic (Domestic Irrigation, Municipal, Industrial, Other)

Description & Color of Materials Sand, Clay, Red Clay, Shell, etc.	Thick- ness Feet	Depth Feet
Blue Clay -		30'
Blue Clay -	30'	220'
Sand -	280' - 285'	
Blue Clay -	285' - 370'	
Sand -	370' - 385'	

Information upon completion of well:

(1) Diameter 4 inches.

(2) Total Depth 390 feet.

(3) Water Level 100 feet below top of ground.

(4) Cased to 142, Size 4"


(5) Screen: Size, Length

(6) Were any formations sealed against pollution? yes, no.

If YES depth of formation

Why

Drillers Remarks:

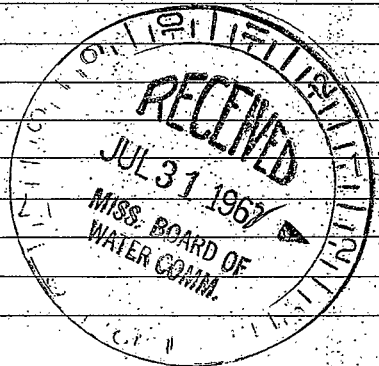

(Use Back Side)

Well No.

