

MISSISSIPPI DEPARTMENT OF NATURAL RESOURCES
 Bureau of Land and Water Resources
 Southport, Mississippi
 P.O. Box 10631
 Jackson, Mississippi 39209
WATER WELL DRILLERS LOG

date well completed 19 firm name _____ county well located _____


LANDOWNER: <u>Bud Phillips</u>	description of formations encountered	from	to
(mailing address)	clay	277 1/2	279
	sand	279	279 1/2
WELL LOCATION: sec. _____ T. _____ N. _____ R. _____ E. _____ S. _____ W. _____ _____ miles (distance) _____ of _____ (direction) of _____ (nearest town)	hard rock	280	
	clay	280	281
	sand	281	283
	clay	283	286
	sand	286	287
	clay	287	291
	sand	291	296
	clay	296	297
	sand	297	302
WELL PURPOSE: (home, irrigation, municipal, industrial)			
WELL COMPLETION DATA: (1) diameter (inches) _____ (2) total depth (feet) _____ (3) static water level (feet) _____ below above top of ground. (4) casing _____ (material) ' _____ (depth) ' _____ (size) if telescope see back. (5) screen _____ (length) ' _____ (depth to top) _____ (size) ' _____ (material) (6) pump _____ (HP) _____ (yield gpm) _____ (type power) _____ (7) electric log _____ (yes or no) _____ (organization running log) _____ (8) how well bottom plugged _____			

DRILLERS REMARKS: _____


DEPT. OF NATURAL RESOURCES
 BUREAU OF LAND & WATER RESOURCES
 OCT 28 1981
RECEIVED

If well telescopes please sketch and show depths.

GROUND LEVEL

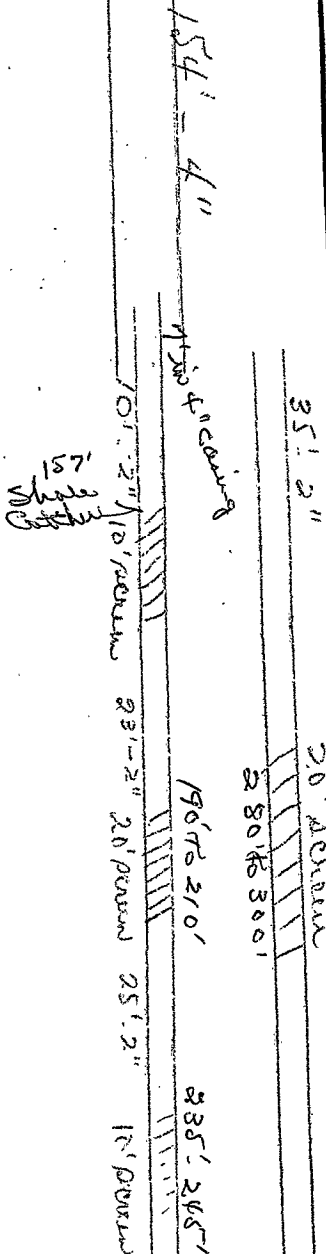

If more than one screen, show locations of each on sketch.

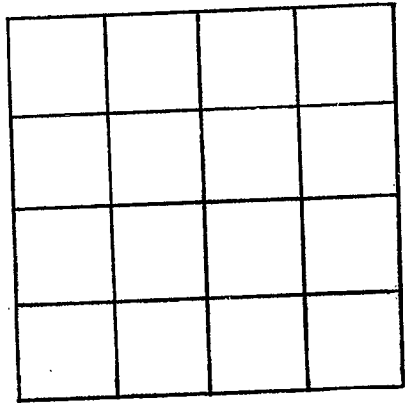

SECTION _____

Please indicate well location X.

ADDITIONAL INFORMATION

Blank lines for additional information.