

MISSISSIPPI DEPARTMENT OF NATURAL RESOURCES

Bureau of Land and Water Resources

Southport Mall

P.O. Box 10631

Jackson, Mississippi 39209

WATER WELL DRILLERS LOG

10-12 1982 Clardy Hill Drilling Lowndes
 date well completed film name county well located

LANDOWNER: Dr. Ben Martin

description of formations encountered	from	to
rock 4"	267 1/2	
sandy clay	267 1/2	272
fine sand	272	274
Dr. rock	274	276
Clay	276	281 1/2
good clay	281 1/2	
sandy clay	281 1/2	282 1/2
rock 3"	282 1/2	
sandy clay	282 1/2	289
good clay	289	296
small rock 2"	296	
Clay	296	311
sandy clay	311	312
rock	312	
fine sandy clay	312	315 1/2
Dr. rock	315 1/2	322
Clay	322	325
rock 2"	325	
Clay	325	326 1/2
rock 3"	326 1/2	
Clay	326 1/2	344
gummy clay	344	346
fine sandy clay	346	364
fine sand	364	367
fine sandy clay	367	389
fine sand	389	396
gray sand	396	407
Clay	407	410
sand	410	413
Clay	413	414
sand	414	422

(mailing address)

WELL LOCATION:
 sec. T N R E
 S W
 miles (distance) of (direction) of (nearest town)

WELL PURPOSE:
 (home, irrigation, municipal, industrial)

WELL COMPLETION DATA:

- (1) diameter (inches)
- (2) total depth (feet)
- (3) static water level (feet) below above top of ground.
- (4) casing (material) (depth) ,
 if telescope see back.
 (size)
- (5) screen (length) (depth to top)
 (size) (material)
- (6) pump (HP) (yield gpm)
 (type power)
- (7) electric log (yes or no)
 (organization running log)
- (8) how well bottom plugged

DRILLERS REMARKS:

NOV 30 1982

RECEIVED

MISSISSIPPI DEPARTMENT OF NATURAL RESOURCES
 BUREAU OF LAND & WATER RESOURCES

If well telescopes please sketch and show depths.

GROUND LEVEL


5.20

11'

1.14 - 3"

20'

sand screen

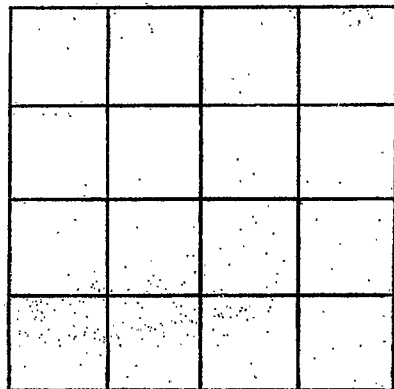

SECTION _____

Please indicate well location X.

ADDITIONAL INFORMATION

If more than one screen, show locations of each on sketch.