

C

8-63

WATER WELL DRILLERS LOG

Date: Aug, 1963, Driller: W. B. Clardy County Lowndes

(Name)


(1) Owner of Land:	Description & Color of Materials Sand, Clay, Red Clay, Shell, etc.	Thick- ness Feet	Depth Feet
(Name) <u>Coun Contractor</u> <u>Columbus, Miss</u> (Address)	Sandy formation		
(2) Location: <u>1/4</u> , <u>1/4</u> , Sec. <u> </u> T. <u> </u> R. <u> </u> <u>2</u> miles <u>NW</u> of <u>Col.</u> (distance) (direction) (Nearest Town)	Down to 115'		
(3) Topography: <u>Hilly</u> (Hilly) (Flat) (Level)	Blue rock 128'		
(4) Purpose of Well: <u>Domestic</u> (Domestic Irrigation Municipal, Industrial, Other)	Sand 212-220		
	Rock 230		
	Sand 275-285		
	Sand 290-320		

Information upon completion of well:

- (1) Diameter 4 inches.
- (2) Total Depth 320 feet.
- (3) Water Level 115 feet below top of ground.
- (4) Cased to 147, Size 4"
- (5) Screen: Size _____, Length _____
- (6) Were any formations sealed against pollution?
 yes, no.

If YES depth of formation _____
Why _____

Drillers Remarks: _____

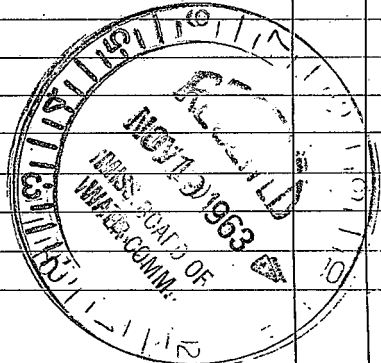

(Use Back Side)

Well No.

