

LOWNOES

WATER WELL DRILLERS LOG

C
4-2-63

Date: April 2, 1963, Driller: W. B. Clardy, County: Lowndes
(Name)

(1) Owner of Land: James Conn Contractor
(Name)
Country Club Homes Sub.
(Address)

(2) Location: 1/4, 1/4, Sec. T R
3 miles N. E. of Cola
(distance) (direction) (Nearest Town)

(3) Topography: Hilly
(Hilly) (Flat) (Level)

(4) Purpose of Well: Domestic
(Domestic Irrigation
Municipal, Industrial, Other)

Description & Color of Materials Sand, Clay, Red Clay, Shell, etc.	Thick- ness Feet	Depth Feet
<u>Blue Clay 15' to 50'</u>		
<u>Sand - 50' - 80'</u>		
<u>Blue Clay 80' - 170'</u>		
<u>Sandy Strata 170' - 190'</u>		
<u>Blue Clay 190 - 270'</u>		
<u>Sandy Strata 270 - 290'</u>		

Information upon completion of well:

(1) Diameter 4 inches.

(2) Total Depth 300' feet.

(3) Water Level _____ feet below top of ground.


(4) Cased to 147', Size 4"

(5) Screen: Size _____, Length _____.

(6) Were any formations sealed against pollution?
_____ yes, _____ no.

If YES depth of formation _____
Why _____

Drillers Remarks: _____

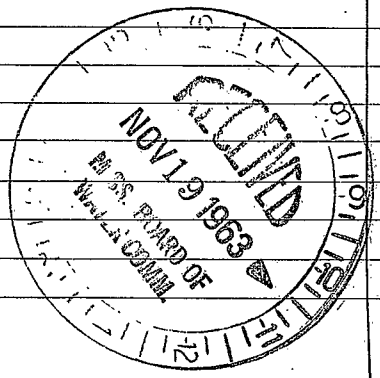

(Use Back Side)

Well No.

1. The first part of the document is a list of names and addresses of the members of the committee.

2. The second part of the document is a list of names and addresses of the members of the committee.

3. The third part of the document is a list of names and addresses of the members of the committee.

4. The fourth part of the document is a list of names and addresses of the members of the committee.

5. The fifth part of the document is a list of names and addresses of the members of the committee.