

LOWNOES MISSISSIPPI BOARD OF WATER COMMISSIONERS

C

4-8-63

WATER WELL DRILLERS LOG

Date: 4/8, 1963, Driller: W B Clardy County Lowndes
(Name)

(1) Owner of Land:	Description & Color of Materials Sand, Clay, Red Clay, Shell, etc.	Thick- ness Feet	Depth Feet
<u>Capt. Jack O'Donel</u> <small>(Name)</small>			
<small>(Address)</small>	<u>Blue Clay 20' - 120'</u>		
(2) Location: <u>1/4</u> , <u>1/4</u> , Sec. <u> </u> T <u> </u> R <u> </u>	<u>Sand 120' - 150'</u>		
<small>(distance) (direction) (Nearest Town)</small>	<u>Blue Clay 150' - 210'</u>		
(3) Topography: <u> </u> (Hilly) <u> </u> (Flat) <u> </u> (Level)	<u>Sandy streaks 210' - 230'</u>		
(4) Purpose of Well: <u>Domestic</u> <small>(Domestic Irrigation Municipal, Industrial, Other)</small>			


Information upon completion of well:

- (1) Diameter 4 inches.
- (2) Total Depth 230 feet.
- (3) Water level feet below top of ground.
- (4) Cased to 105', Size 4"
- (5) Screen: Size , Length .
- (6) Were any formations sealed against pollution?
 yes, no.

If YES depth of formation

Why

Drillers Remarks:

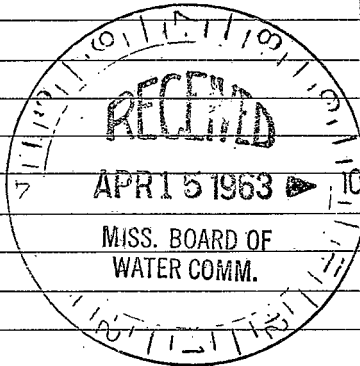

(Use Back Side)

Well No.

