

Lowndes
C 42
11-16-68

MISSISSIPPI
 BOARD OF WATER COMMISSIONERS
 416 North State Street
 Jackson, Mississippi 39201

CODED

WATER WELL DRILLERS LOG

11-16 1968 W. J. REEVES & SON LOWNDES
 date well completed firm name county well located

LANDOWNER: JOHN PERKINS
RT. 5 HW 45N 3280537

COLUMBUS, MISS
 (mailing address)

WELL LOCATION:
 sec. 33T17 R18W
S
1 miles N of COLUMBUS
 (distance) (direction) (nearest town)

WELL PURPOSE: HOME
 (home, irrigation, municipal, industrial)

WELL COMPLETION DATA:

- (1) diameter (inches) 4
- (2) total depth (feet) 220
- (3) static water level (feet) 57 below above top of ground.
- (4) casing STEEL 105'
 (material) (depth)
4 If telescope see back.
 (size)
- (5) screen NONE
 (length) (depth to top)
 (size) (material)
- (6) pump 3/4 10
 (HP) (yield gpm)
ELECT.
 (type power)
- (7) electric log No
 (Yes or no)
 (organization running log)
- (8) how well bottom plugged OPEN

description of formations encountered	from	to
BLUE SANDY CLAY	0	88
BLUE SAND	88	96
BLUE CLAY	96	115
BLUE SAND-CLAY STRAS	115	150
BLUE CLAY	150	162
BLUE SAND	162	171
BLUE CLAY	171	188
BLUE SAND	188	193
BLUE CLAY-SAND STRAS	193	220

CODED
CODED


JAN 11 1969

MISS. BD. OF
 WATER COMMISSIONERS

DRILLERS REMARKS:

If well telescopes please sketch and show depths.

GROUND LEVEL

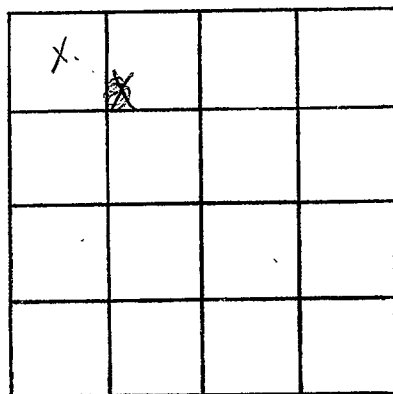

SECTION 33

Please indicate well location X.

ADDITIONAL INFORMATION

If more than one screen,
show locations of each on sketch.