

CODED

MISSISSIPPI
BOARD OF WATER COMMISSIONERS
416 North State Street
Jackson, Mississippi 39201

WATER WELL DRILLERS LOG

Loundes

C43

11-19-68

11-19
date well completed

W. J. REEVES & SON
firm name

LOWNDES
county well located

LANDOWNER: PETE BOWEN

915 4th AV S

STAR RT. 3280416

COLUMBUS, MISS.
(mailing address)

WELL LOCATION:

sec. 36 T17 S

R18 E

3 miles N of COLUMBUS
(distance) (direction) (nearest town)

WELL PURPOSE: HOME TRIPPER
(home, irrigation, municipal, industrial)

WELL COMPLETION DATA:

(1) diameter (inches) 4

(2) total depth (feet) 110

(3) static water level (feet) 9 below
top of ground. above

(4) casing STEEL, 24'
(material) (depth)

4
(size) If telescope see back.

(5) screen NONE
(length) (depth to top)

(size) (material)

(6) pump NONE
(HP) (yield gpm)

(type power)

(7) electric log No
(yes or no)

(organization running log)

(8) how well bottom plugged OPEN

DRILLERS REMARKS:

description of formations encountered

from

to

<u>SANDY CLAY</u>	<u>0</u>	<u>13</u>
<u>SAND & GRAVEL</u>	<u>13</u>	<u>20</u>
<u>BLUE CLAY</u>	<u>20</u>	<u>38</u>
<u>BLUE SAND - CLAY STRKS.</u>	<u>38</u>	<u>67</u>
<u>BLUE CLAY</u>	<u>67</u>	<u>75</u>
<u>BLUE SAND</u>	<u>75</u>	<u>79</u>
<u>BLUE CLAY</u>	<u>79</u>	<u>98</u>
<u>BLUE SAND</u>	<u>98</u>	<u>106</u>
<u>BLUE CLAY</u>	<u>106</u>	<u>110</u>


CODED

JAN 10 1969

MISS. BD. OF
WATER COMMISSIONERS

If well telescopes please sketch and show depths.

GROUND LEVEL

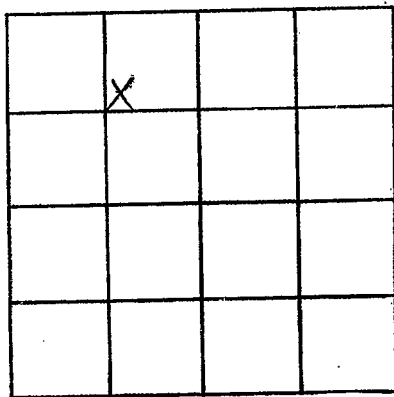

SECTION 36

Please indicate well location X.

ADDITIONAL INFORMATION

If more than one screen, show locations of each on sketch.