

Lowndes
 C 44
 8-68

MISSISSIPPI
 BOARD OF WATER COMMISSIONERS
 416 North State Street
 Jackson, Mississippi 39201

CODED
CODED

WATER WELL DRILLERS LOG

CODED

Aug. 19 68 Clardy Well Drilling Lowndes
 date well completed firm name county well located

LANDOWNER: Joe Brown

description of formations encountered

from to

Hwy 12 3273065
 Columbus, Miss.
 (mailing address)

Clay Gravel & Sand	0	35
Blue Clay	30	120
Sand	120	130
Blue Clay	130	160
Sand	160	175

WELL LOCATION:

sec 25 T 17 N R 18 E W

(distance) miles (direction) of (nearest town)

WELL PURPOSE: Home
 (home, irrigation, municipal, industrial)

WELL COMPLETION DATA:

(1) diameter (inches) 4"
 (2) total depth (feet) 175'
 (3) static water level (feet) 12 below top of ground.

CODED

(4) casing 58'-9"
 (material) (depth)

(size) if telescope see back.

(5) screen (length) (depth to top)

(size) (material)

(6) pump hand pump
 (HP) (yield gpm)

(type power)

(7) electric log (yes or no)

(organization running log)

(8) how well bottom plugged


DEC 13 1968

MISS. BD. OF
 WATER COMMISSIONERS

DRILLERS REMARKS:

If well telescopes please sketch and show depths.

GROUND LEVEL

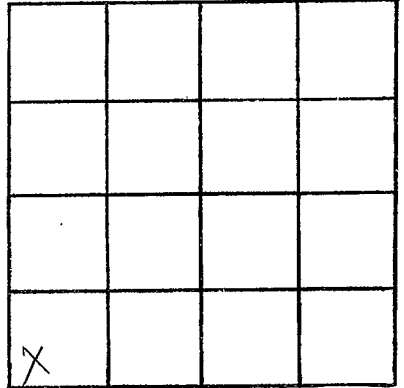

SECTION 25

Please indicate well location X.

ADDITIONAL INFORMATION

If more than one screen, show locations of each on sketch.