

CODED

CODED

CODED

Lowndes  
C46  
2-69

MISSISSIPPI  
BOARD OF WATER COMMISSIONERS  
416 North State Street  
Jackson, Mississippi 39201

WATER WELL DRILLERS LOG

Feb. 19 69 Clardy Well Drilling Lowndes  
date well completed firm name county well located

LANDOWNER:

Phillips Contracting Co.  
Columbus, Miss.  
WATERWORKS RD 328625 (mailing address)  
1491 MOSS 328626 (mailing address)

WELL LOCATION:

sec 5 T 19 N R 18 W  
(distance) miles (direction) of (nearest town)

WELL PURPOSE:

ind. (home, irrigation, municipal, industrial)

WELL COMPLETION DATA:

- (1) diameter (inches) 4"
- (2) total depth (feet) 225
- (3) static water level (feet) 7 below top of ground.
- (4) casing Steel 61' (material) (depth)
- (size) if telescope see back.
- (5) screen (length) (depth to top) (size) (material)
- (6) pump (HP) (yield gpm) (type power)
- (7) electric log (yes or no) (organization running log)
- (8) how well bottom plugged

description of formations encountered

from to

Sand & gravel	0	20
blue Clay	20	30
Sandy Clay	30	55
blue Clay	55	70
Sand	70	80
blue Clay	80	110
Sand	110	130
blue Clay	130	130
Sand	130	140
Sand & Clay	140	150
Sand	150	160
blue Clay	160	165
Sand	165	170
Clay	170	207
Shale, Sand & Sand	200	225

CODED

CODED


DRILLERS REMARKS:

MAR 11 1969

MISS. Bd. OF WATER COMM.

If well telescopes please sketch and show depths.

GROUND LEVEL

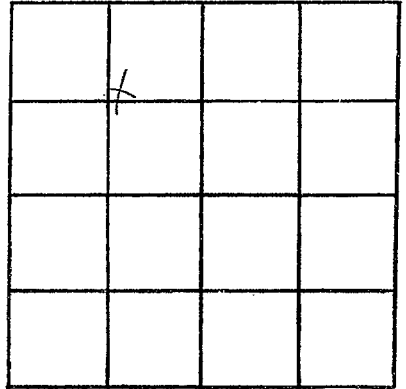

SECTION 5

Please indicate well location X.

ADDITIONAL INFORMATION

If more than one screen, show locations of each on sketch.