

LOWNDES

C 47

6-26-72

MISSISSIPPI BOARD OF WATER COMMISSIONERS
416 North State Street
Jackson, Mississippi 39201

CODED

WATER WELL DRILLERS LOG

June 26 1972
date well completed

J.W. Webb & Sons
firm name

Lowndes
county well located

LANDOWNER: Bobby Thompson
Rt #5 Box 23
Columbus, Miss
(mailing address)

description of formations encountered

from to

Topsoil SAND & GRAVEL 0 63
soft blue MARL 63 140
light to dark blue SAND 140 200

WELL LOCATION:

sec 20 T 17 N R 18
5 miles N of Columbus
(distance) (direction) (nearest town)

WELL PURPOSE: home
(home, irrigation, municipal, industrial)

WELL COMPLETION DATA:

- (1) diameter (inches) 4
- (2) total depth (feet) 200
- (3) static water level (feet) 20 ^{below} above top of ground.
- (4) casing ~~4 1/2~~ 4 3/4 ft
(material) (depth)
4 1/2 Steel
(size) if telescope see back.
- (5) screen none
(length) (depth to top)
none
(size) (material)
- (6) pump none
(HP) (yield gpm)
none
(type power)
- (7) electric log no
(yes or no)
X
(organization running log)
- (8) how well bottom plugged open hole

CODED

OCT 13 1972


DRILLERS REMARKS:

Lots of GRAVEL on top

MISS. DEPT. OF WATER RESOURCES

If well telescopes please sketch and show depths.

GROUND LEVEL

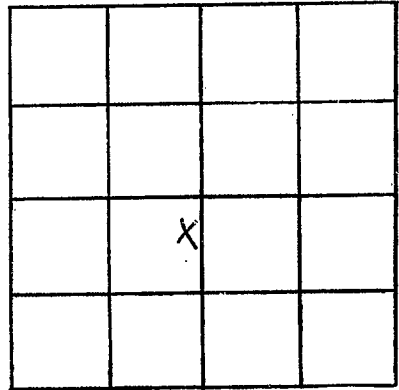

SECTION 20

Please indicate well location X.

ADDITIONAL INFORMATION

If more than one screen, show locations of each on sketch.