

LOWNDES
C 48
4-30-69

MISSISSIPPI
 BOARD OF WATER COMMISSIONERS
 416 North State Street
 Jackson, Mississippi 39201

CODED

328-4850

WATER WELL DRILLERS LOG

April 30 19 69 Columbus Well Drilling Lowndes
 date well completed firm name county well located

LANDOWNER: George Schweitzer
Crescent Estates
Columbus, Miss.
 (mailing address)

WELL LOCATION:
 sec 28 T. 17 N. R. 18 E
 S W
5 miles North of Columbus
 (distance) (direction) (nearest town)

WELL PURPOSE:
 (home irrigation, municipal, industrial)

- WELL COMPLETION DATA:
- (1) diameter (inches) 4"
 - (2) total depth (feet) 315'
 - (3) static water level (feet) 70 below above top of ground.
 - (4) casing Steel, 82'
 (material) (depth)
 _____ if telescope see back.
 (size)
 - (5) screen None, _____
 (length) (depth to top)
 (size) (material)
 - (6) pump 3/4 _____
 (HP) (yield gpm)
 - (type power)
 - (7) electric log No
 (yes or no)

 (organization running log)
 - (8) how well bottom plugged Open

description of fomations encountered	from	to
Sandy clay	0	20
Hard blue sand	20	40
Soft blue sand	40	70
Hard sandy blue clay	70	98
Sandy streak	98	103
Hard sandy blue clay	103	110
Streaks of fine sand & clay	110	155
Blue clay	155	175
Sandy blue clay	175	225
Blue clay	225	295
Sand	295	315

DRILLERS REMARKS:

SEP 3 1969


MISS. BD. OF
 WATER COMMISSIONERS

1969

MISS. BD. OF
 WATER COMMISSIONERS

If well telescopes please sketch and show depths.

GROUND LEVEL

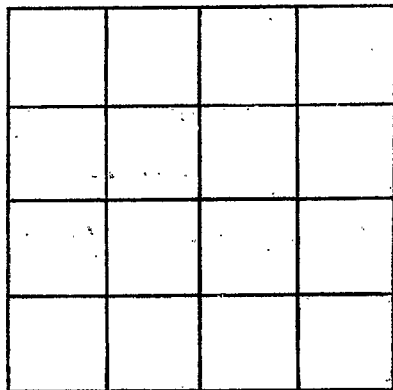

SECTION _____

Please indicate well location X.

ADDITIONAL INFORMATION

If more than one screen,
show locations of each on sketch.