

Lowndes Co.  
C 49  
4-25-70

MISSISSIPPI  
BOARD OF WATER COMMISSIONERS  
416 North State Street  
Jackson, Mississippi 39201

**CODED**  
**CODED**

**WATER WELL DRILLERS LOG**

4/25 1970 DALLSUP DRILLING CO. LOWNDES  
date well completed firm name county well located  
*DEAN MCKINLEY ON A.S.N. JUST PAST BLUE CUT RP.*

LANDOWNER: DEAN MCKINLEY  
Mayo DOWDLE  
Columbus, Miss  
(mailing address)

description of formations encountered	from	to
<u>CLAY</u>	<u>0</u>	<u>20</u>
<u>BLUE ROCK</u>	<u>20</u>	<u>61</u>
<u>SAND + ROCK</u>	<u>61</u>	<u>184</u>

WELL LOCATION:  
sec. 32 T. 17 R. 18  
3/4 miles North of Columbus  
(distance) (direction) (nearest town)

WELL PURPOSE: HOME  
(home, irrigation, municipal, industrial)

WELL COMPLETION DATA:

(1) diameter (inches) 4" x ~~4~~

(2) total depth (feet) 184'

(3) static water level (feet) 38' below above ground.

(4) casing Plastic 184'  
(material) (depth)  
(size) if telescope see back.

(5) screen 84' 100'  
(length) (depth to top)  
4" PLASTIC  
(size) (material)

(6) pump 1 (HP) (yield gpm)  
ELECTRIC  
(type power)

(7) electric log No  
(yes or no)

\_\_\_\_\_  
(organization running log)

(8) how well bottom plugged \_\_\_\_\_

**CODED**


MAY 22 1970

MISS. Bd. of  
WATER COMMISSIONERS

DRILLERS REMARKS:

If well telescopes please sketch and show depths.

GROUND LEVEL

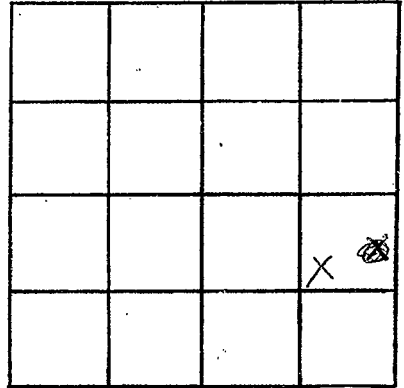

SECTION 32

Please indicate well location X.

ADDITIONAL INFORMATION

If more than one screen, show locations of each on sketch.