

MISSISSIPPI
 BOARD OF WATER COMMISSIONERS
 416 North State Street
 Jackson, Mississippi 39201

CODED

WATER WELL DRILLERS LOG

LOWNDES
 C 50
 6-25-70

6-25-70 19 Columbus Well Drilling Lowndes
 date well completed firm name county well located

LANDOWNER:
 Bill Wright
 Airbase Trailer Park
 Columbus, Miss.
 (mailing address)

434-6712

description of formations encountered	from	to
Top soil	0	6
White sand	6	12
Gravel & sand	12	20
Blue clay	20	25
Blue clay with some black sand	25	67
Blue clay with some sand	67	75
Blue clay with heavy black sand	75	108
Blue clay with black sand, some fine gravel	108	129
Blue clay with heavy black sand & fine gravel	129	150
Blue clay with heavy black sand	150	171

WELL LOCATION:
 sec. 17 T. 17 N. R. 18 E.
 10 miles N of Columbus
 (distance) (direction) (nearest town)

WELL PURPOSE: Industrial
 (home, irrigation, municipal, industrial)

- WELL COMPLETION DATA:**
- diameter (inches) 4"
 - total depth (feet) 171
 - static water level (feet) 25 below top of ground.
 - casing Steel 75'
(material) (depth)
(size) if telescope see back.
 - screen No
(length) (depth to top)
(size) (material)
 - pump did not install
(HP) (yield gpm)
(type power)
 - electric log No
(yes or no)
(organization running log)
 - how well bottom plugged open


CODED

SEP 17 1970

DRILLERS REMARKS:

If well telescopes please sketch and show depths.

GROUND LEVEL

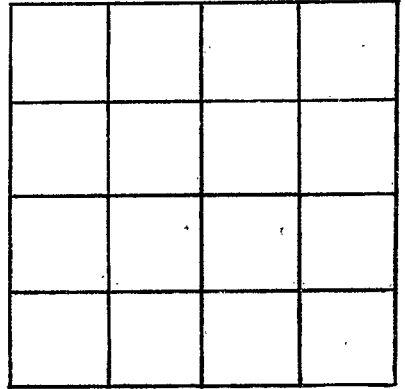

SECTION _____

Please indicate well location X.

ADDITIONAL INFORMATION

A series of horizontal lines for recording additional information.

If more than one screen, show locations of each on sketch.