

LOWNDES

C 53

4-15-70

MISSISSIPPI
 BOARD OF WATER COMMISSIONERS
 416 North State Street
 Jackson, Mississippi 39201

CODED

WATER WELL DRILLERS LOG

4-15 1970 W. J. REEVES & SON LOWNDES
 date well completed firm name county well located

LANDOWNER: DARL NICHOLSON

4348730

RT. 5 Mike PARRA RD.

COLUMBUS

(mailing address)

WELL LOCATION:

sec. 5 T 17 R 18
 8 miles NO of COLUMBUS
 (distance) (direction) (nearest town)

WELL PURPOSE: IND. MOBILE HOME
 (home, irrigation, municipal, industrial)

WELL COMPLETION DATA:

- (1) diameter (inches) 4
- (2) total depth (feet) 158
- (3) static water level (feet) 20 below above top of ground.
- (4) casing STEEL 36
 (material) (depth)
4 if telescope see back.
 (size)
- (5) screen NONE
 (length) (depth to top)
 (size) (material)
- (6) pump 1 35
 (HP) (yield gpm)
ELECT
 (type power)
- (7) electric log NO
 (yes or no)
 (organization running log)
- (8) how well bottom plugged OPEN

description of formations encountered

from

to

SANDY CLAY	0	9
SAND & GRAVEL	9	26
BLUE CLAY & SAND	26	32
" CLAY	32	50
" SAND	50	54
" CLAY	54	58
" SAND	58	65
" CLAY	65	78
" SAND	78	82
" CLAY	82	105
" SAND	105	122
" CLAY	122	135
" SAND	135	158

CODED


AUG 23 1970

DRILLERS REMARKS:

MISS. BD. OF WATER COMM.

If well telescopes please sketch and show depths.

GROUND LEVEL

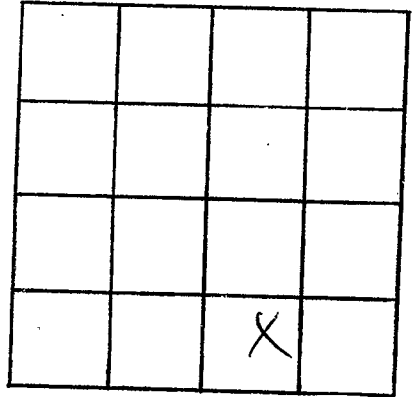

SECTION 5

Please indicate well location X.

ADDITIONAL INFORMATION

If more than one screen, show locations of each on sketch.