

LOWNDES

CSS

6-18-70

MISSISSIPPI BOARD OF WATER COMMISSIONERS
416 North State Street
Jackson, Mississippi 39201

CODED

WATER WELL DRILLERS LOG

6-18 1970 W.J. REEVES & SON LOWNDES
date well completed firm name county well located

LANDOWNER: FREEMAN BROS.

RIDGE RD.

COLUMBUS
(mailing address)

WELL LOCATION:
sec. 36 T-17 R-30
3 miles NW of COLUMBUS
(distance) (direction) (nearest town)

WELL PURPOSE: HOME
(home, irrigation, municipal, industrial)

WELL COMPLETION DATA:

- (1) diameter (inches) 4
- (2) total depth (feet) 158
- (3) static water level (feet) 12 below top of ground.
- (4) casing STEEL 64
(material) (depth)
4 (size) if telescope see back.
- (5) screen NONE
(length) (depth to top)
(size) (material)
- (6) pump NONE
(HP) (yield gpm)
(type power)
- (7) electric log NO
(yes or no)
(organization running log)
- (8) how well bottom plugged OPEN

description of formations encountered	from	to
SANDY CLAY	0	9
RED SAND	9	21
SAND & GRAVEL	21	34
RED SAND	34	55
BLUE CLAY	55	121
" SAND	121	134
" CLAY	134	138
" SAND	138	158

CODED


AUG 26 1970

DRILLERS REMARKS:

MISS. BD. OF WATER COMM.

If well telescopes please sketch and show depths.

GROUND LEVEL

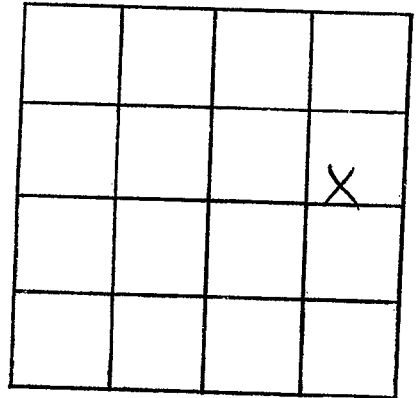

SECTION 86

Please indicate well location X.

ADDITIONAL INFORMATION

If more than one screen, show locations of each on sketch.